

\$ 888.00
 TAX 40 40
 888.40

MISSISSIPPI
 BOARD OF WATER COMMISSIONERS
 416 North State Street
 Jackson, Mississippi 39201

CODED

WATER WELL DRILLERS LOG

TIPPAH
 0-10
 7-23-71

7-23-1971 date well completed
 J. T. Medlin firm name
 Tippah county well located

LANDOWNER: Jack Hopkins
 R# 4
 Falkner
 (mailing address)

| description of formations encountered | from | to |
|---------------------------------------|------|-----|
| Red Clay | 0 | 12 |
| Yellow clay | 12 | 28 |
| White clay | 28 | 48 |
| Clay " " | 48 | 375 |
| Rock & sand | 375 | 485 |

WELL LOCATION:
 sec. 32 T 2 N R 3 E
 S W
 5 1/2 miles West of Tippah
 (distance) (direction) (nearest town)

WELL PURPOSE:
 (home, irrigation, municipal, industrial)

- WELL COMPLETION DATA:
- (1) diameter (inches) 4
 - (2) total depth (feet) 485
 - (3) static water level (feet) 210 below above top of ground.
 - (4) casing P 260 (material) (depth)
 (size) if telescope see back.
 - (5) screen (length) (depth to top)
 (size) (material)
 - (6) pump 1/2 5 (HP) (yield gpm)
 (type power)
 - (7) electric log (yes or no)
 (organization running log)
 - (8) how well bottom plugged

CODED


AUG 4 - 1971

DRILLERS REMARKS:

MISS. BD. OF
 WATER COMM.

If well telescopes please sketch and show depths.

GROUND LEVEL

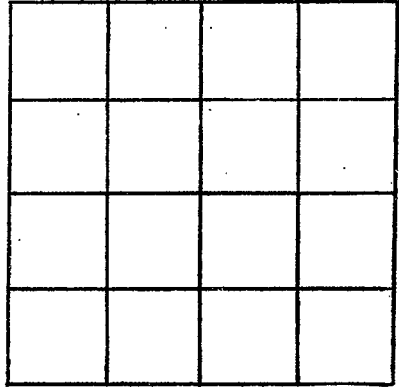

SECTION _____

Please indicate well location X.

ADDITIONAL INFORMATION

If more than one screen,
show locations of each on sketch.