

TIPPAH
 D12
 4-3-72

MISSISSIPPI
 BOARD OF WATER COMMISSIONERS
 416 North State Street
 Jackson, Mississippi 39201

\$ 610.00
 Tax 30.00
 640.00

WATER WELL DRILLERS LOG

4-3-1972 date well completed
 J T Medlin firm name
 TipPAH
 county indicated

LANDOWNER: Grady Childers
Blue Mt
R#2
 (mailing address)

Description of formations encountered	from	to
Clay	0	18
Sand + Clay	18	90
Blue "	90	104
Sand	104	114
blue "	114	128
Sand + rock	128	175

WELL LOCATION:
 sec 8 T 5 N R 4 E
Buna Vista
 (distance) (direction) (nearest town)


WELL PURPOSE:
 (home, irrigation, municipal, industrial)

- WELL COMPLETION DATA:
- (1) diameter (inches) 4
- (2) total depth (feet) 175
- (3) static water level (feet) 90 below above top of ground.
- (4) casing P 85
 (material) (depth)
 (size) if telescope see back.
- (5) screen _____
 (length) (depth to top)
 (size) (material)
- (6) pump 1/2 4
 (HP) (yield gpm)
E
 (type power)
- (7) electric log (yes or no) _____
 (organization running log) _____
- (8) how well bottom plugged _____

DRILLERS REMARKS:

If well telescopes please sketch and show depths.

GROUND LEVEL

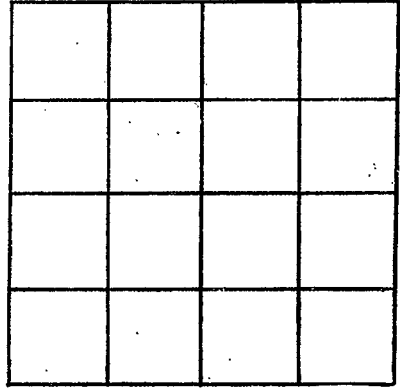

SECTION _____

Please indicate well location X.

ADDITIONAL INFORMATION

A series of horizontal lines providing space for additional information.

If more than one screen, show locations of each on sketch.