

TIPPAH
 Ø13
 4-5-72

MISSISSIPPI
 BOARD OF WATER COMMISSIONERS
 416 North State Street
 Jackson, Mississippi 39201

500.00
 2500

WATER WELL DRILLERS LOG

7-5-72 date well completed 1972 J.T. Modlin firm name CONE h County Well Located

LANDOWNER: Richard Eaton	description of formations encountered	from	to
Blue water #2			
	sand + clay	11	36
	Blue "	36	80
	Rock + sand	80	140

WELL LOCATION:
 sec. 18 T 5 N R 4 E
 1 miles W. of Buxton

WELL PURPOSE:
 (home, irrigation, municipal, industrial)

- WELL COMPLETION DATA:
- (1) diameter (inches) 4
 - (2) total depth (feet) 140
 - (3) static water level (feet) 12 below top of ground.
 - (4) casing P 60 (material) (depth)
 - (size) if telescope see back.
 - (5) screen (length) (depth to top)
 - (size) (material)
 - (6) pump 1/2 8 (HP) (yield gpm)
 - E (type power)
 - (7) electric log (yes or no)
 - (organization running log)
 - (8) how well bottom plugged

CONF


MSW 9-1072

DRILLERS REMARKS:

MISS. BD. OF
 WATER COMM.

If well telescopes please sketch and show depths.

GROUND LEVEL

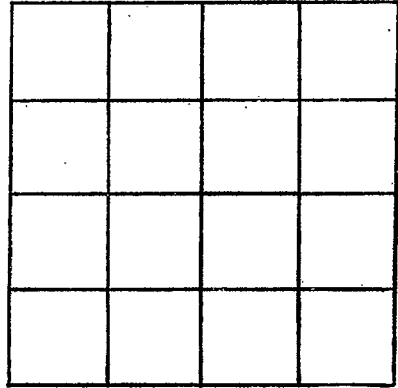

SECTION _____

Please indicate well location X.

ADDITIONAL INFORMATION

A series of horizontal lines for writing additional information, starting below the 'ADDITIONAL INFORMATION' header and extending to the bottom of the page.

If more than one screen, show locations of each on sketch.