

TIPPAH
 #16
 6-16-72

MISSISSIPPI
 BOARD OF WATER COMMISSIONERS
 416 North State Street
 Jackson, Mississippi 39201

760.00
 38.00
 798.00
 Tippah

WATER WELL DRILLERS LOG

6 16 19 72 date well completed
 J T Modlin firm name
 Tippah county/well located


LANDOWNER: <u>Willie B. Harris</u>	description of formations encountered	from	to
<u>Blue Water #2</u> (mailing address)	<u>Clay</u>	<u>0</u>	<u>18</u>
	<u>Rock & sand</u>	<u>18</u>	<u>96</u>
	<u>Blue clay</u>	<u>96</u>	<u>160</u>
	<u>Rock & sand</u>	<u>160</u>	<u>250</u>
WELL LOCATION: sec. <u>25</u> T <u>5</u> N R <u>4</u> E <u>2</u> miles <u>W</u> of <u>Kanawville</u> (distance) (direction) (nearest town)			
WELL PURPOSE: (home, irrigation, municipal, industrial)			
WELL COMPLETION DATA: (1) diameter (inches) <u>4</u> (2) total depth (feet) <u>250</u> (3) static water level (feet) <u>103</u> below above top of ground. (4) casing <u>P</u> <u>130</u> (material) (depth) _____ if telescope see back. (size) (5) screen _____ (length) (depth to top) (size) (material) (6) pump <u>1</u> <u>4</u> (HP) (yield gpm) <u>E</u> (type power) (7) electric log _____ (yes or no) (organization running log) (8) how well bottom plugged _____			
DRILLERS REMARKS:			

JUL 18 1972

MISS. DD. OF
 WATER

If well telescopes please sketch and show depths.

GROUND LEVEL

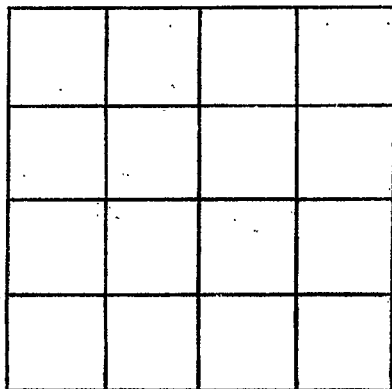

SECTION _____

Please indicate well location X.

ADDITIONAL INFORMATION

If more than one screen,
show locations of each on sketch.