

F.H.A.

\$ 700 00
35 00
735 00

TIPPAH
Ø 17
9-21-72

MISSISSIPPI
BOARD OF WATER COMMISSIONERS
416 North State Street
Jackson, Mississippi 39201

WATER WELL DRILLERS LOG

CODED

9 21 1972 date well completed
J T Medlin firm name
Tippah county well located

LANDOWNER:
James Strickland
Dumas, Miss
(mailing address)

| description of formations encountered | from | to |
|---------------------------------------|------|-----|
| red clay | 0 | 27 |
| sand + clay | 27 | 160 |
| blue clay | 160 | 175 |
| sand | 175 | 200 |

WELL LOCATION:
sec 25 T 5 N R 4 E
2 miles S.W. of Dumas
(distance) (direction) (nearest town)

WELL PURPOSE:
(home, irrigation, municipal, industrial)

- WELL COMPLETION DATA:
- (1) diameter (inches) 4
 - (2) total depth (feet) 210
 - (3) static water level (feet) 93 below top of ground.
 - (4) casing P 160 (material) (depth)
 - (5) screen 10 150 (length) (depth to top)
4 P (size) (material)
 - (6) pump 2 6 (HP) (yield gpm)
E (type power)
 - (7) electric log (yes or no)
 - (8) how well bottom plugged

CODED


NOV 10 1972

DRILLERS REMARKS:

an OF
ADDITIONAL
REMARKS

If well telescopes please sketch and show depths.

GROUND LEVEL

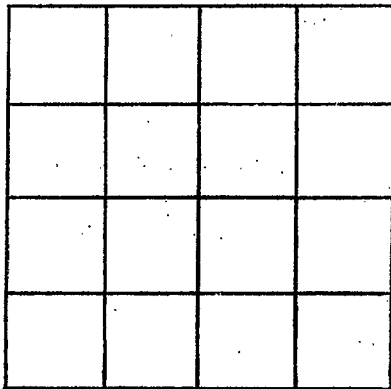

SECTION _____

Please indicate well location X.

ADDITIONAL INFORMATION

If more than one screen,
show locations of each on sketch.