

TIPPAM  
 18  
 10-26-72

MISSISSIPPI  
 BOARD OF WATER COMMISSIONERS  
 416 North State Street  
 Jackson, Mississippi 39201

760.00  
 45.00  
 805.00  
**CODED**

WATER WELL DRILLERS LOG

10-26-1972 *T. Medlin*  
 date well completed firm name county well located

LANDOWNER: *T. Medlin*  
 description of formations encountered from to  
*Clay* 0 18  
*Hard ss - 1/2" blue* 18 70  
 (mailing address) *Dickinson Blvd* 90 160

WELL LOCATION:  
 sec. 13 T 5 N R 4 E  
 S W  
 (distance) miles 2.6 of Knappa, La.  
 (direction) (nearest town)

WELL PURPOSE:  
 (home, irrigation, municipal, industrial)

WELL COMPLETION DATA:  
 (1) diameter (inches) 4  
 (2) total depth (feet) 160  
 (3) static water level (feet) 70 below/above top of ground.  
 (4) casing P 160  
 (material) (depth)  
 (size) if telescope see back.  
 (5) screen 10 150  
 (length) (depth to top)  
 (size) (material)  
 (6) pump 1 5  
 (HP) (yield gpm)  
 (type power)  
 (7) electric log (yes or no)  
 (organization running log)  
 (8) how well bottom plugged Cap


**CODED**

DEC 21 1972

DRILLERS REMARKS:

If well telescopes please sketch and show depths.

GROUND LEVEL

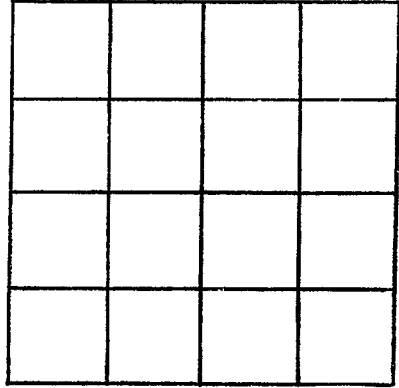

SECTION \_\_\_\_\_

Please indicate well location X.

ADDITIONAL INFORMATION

Lined area for additional information.

If more than one screen, show locations of each on sketch.