

TIPPAH

019

1-23-73

MISSISSIPPI BOARD OF WATER COMMISSIONERS  
416 North State Street  
Jackson, Mississippi 39201

650.00  
3250  
1850

WATER WELL DRILLERS LOG

CODED

123

1923

J T Medlin

Tippan

date well completed

firm name

county well located

LANDOWNER:

Boez W Chism  
J Ripley  
(mailing address)

description of formations encountered

clay  
rock of sand  
blue clay  
rock of sand

from to  
0 16  
16 60  
60 120  
120 180

WELL LOCATION:

sec. 8 T. 5 N. R. 4 E  
6 miles E of Blue Mt.  
(distance) (direction) (nearest town)

WELL PURPOSE:

(home, irrigation, municipal, industrial)

WELL COMPLETION DATA:

- (1) diameter (inches) 4
- (2) total depth (feet) 100
- (3) static water level (feet) 90 below above top of ground.
- (4) casing P (material), 30 (depth)  
(size) if telescope see back.
- (5) screen 0 (length), (depth to top)  
(size) (material)
- (6) pump 1 (HP), 5 (yield gpm)  
C (type power)
- (7) electric log (yes or no)
- (organization running log)
- (8) how well bottom plugged open

CODED


FEB 5 1973

DRILLERS REMARKS:

MIS. WATER COM.

If well telescopes please sketch and show depths.

GROUND LEVEL

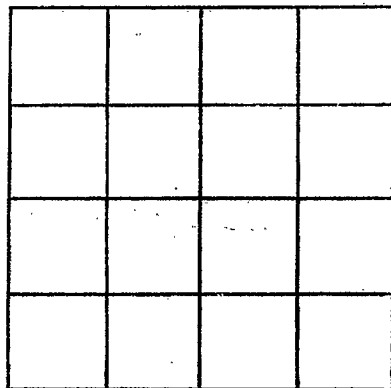

SECTION \_\_\_\_\_

Please indicate well location X.

ADDITIONAL INFORMATION

If more than one screen, show locations of each on sketch.