

TIPPAH
 Ø 20
 5-5-73

MISSISSIPPI
 BOARD OF WATER COMMISSIONERS
 416 North State Street
 Jackson, Mississippi 39201

200.00
 14000
 14000

CODED

WATER WELL DRILLERS LOG

5-5-73 date well completed 19 23 firm name J T Madala county well located Tippah

LANDOWNER	description of formations encountered	from	to
James Windham	Red clay	0	16
Blue Mt (mailing address)	rock & sand	16	56
	Blue clay	56	120
	sand	120	180

WELL LOCATION:
 sec. 16 T. 5 N. R. 4 E
 6 miles (distance) S of Blue Mt (direction) of (nearest town)

WELL PURPOSE:
 (home, irrigation, municipal, industrial)

- WELL COMPLETION DATA:
- (1) diameter (inches) 4
 - (2) total depth (feet) 170
 - (3) static water level (feet) 90 below top of ground.
 - (4) casing (material) P (depth) 70
 - (5) screen (size) 10 (length) 170 (depth to top) P
 - (6) pump (size) 1/2 (material) 6 (HP) (yield gpm)
 - (7) electric log (yes or no)
 - (8) how well bottom plugged Cap

CODED


MISSISSIPPI BOARD OF WATER COMMISSIONERS

MISS. B.O.W.C.
 WATER LOG

DRILLERS REMARKS:

If well telescopes please
sketch and show depths:

GROUND LEVEL

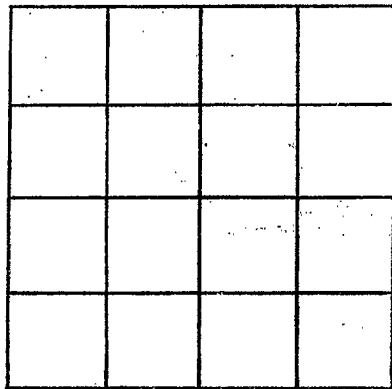

SECTION _____

Please indicate well location X.

ADDITIONAL INFORMATION

If more than one screen,
show locations of each on sketch.