

TIPPAN
 021
 4-8-75

MISSISSIPPI
 BOARD OF WATER COMMISSIONERS
 416 North State Street
 Jackson, Mississippi 39201

CODED

WATER WELL DRILLERS LOG

4 R 19 75 J T McMillin Tippah
 date well completed firm name county well located

LANDOWNER: Ben McMillan
 description of formations encountered from to
 red clay 0 18
 5" sand 18 76
 blue clay 76 160
 sand 160 190
 (mailing address)

WELL LOCATION:
 sec 34 T 5 N R 4 E
 3 miles W of Kossuth
 (distance) (direction) (nearest town)

WELL PURPOSE:
 (home, irrigation, municipal, industrial)

WELL COMPLETION DATA:
 (1) diameter (inches) 4
 (2) total depth (feet) 190
 (3) static water level (feet) 110 below above top of ground.
 (4) casing P 190 (material) (depth)
 (size) If telescope see back.
 (5) screen 10 180 (length) (depth to top)
 4 P (size) (material)
 (6) pump 1/2 6 (HP) (yield gpm)
 6 (type power)
 (7) electric log (yes or no)
 (organization running log)
 (8) how well bottom plugged Cays

CODED

RECEIVED


APR 18 1975

MISS. BD. OF WATER COMM

DRILLERS REMARKS:

If well telescopes please sketch and show depths.

GROUND LEVEL

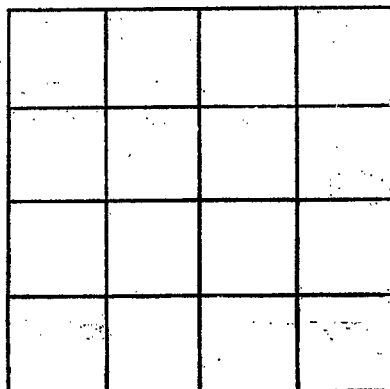

SECTION _____

Please indicate well location X.

ADDITIONAL INFORMATION

If more than one screen,
show locations of each on sketch.