

0 22  
 Lumbah  
 5/9/75

MISSISSIPPI  
 BOARD OF WATER COMMISSIONERS  
 416 North State Street  
 Jackson, Mississippi 39201

CODED

WATER WELL DRILLERS LOG

5 9 75 *J. T. Miller* *Lumbah*  
 date well completed 19 firm name county well located

LANDOWNER: <i>C. M. Woodley</i>	Description of formations encountered	from	to
<i>Ripley Peoples Rd</i> (mailing address)	<i>Clay</i>	<i>10</i>	<i>18</i>
WELL LOCATION: sec <i>10</i> T <i>5</i> N R <i>4</i> E S W miles of (distance) (direction) (nearest town)			
WELL PURPOSE: (home, irrigation, municipal, industrial)			
WELL COMPLETION DATA:			
(1) diameter (inches) <i>4</i>			
(2) total depth (feet) <i>140</i>			
(3) static water level (feet) <i>70</i> below above top of ground.			
(4) casing <i>P</i> <i>140</i> (material) (depth)			
_____ If telescope see back. (size)			
(5) screen <i>10</i> <i>130</i> (length) (depth to top)			
<i>4</i> <i>P</i> (size) (material)			
(6) pump <i>1/2</i> <i>6</i> (HP) (yield gpm)			
<i>C</i> (type power)			
(7) electric log _____ (yes or no)			
_____ (organization running log)			
(8) how well bottom plugged <i>Cop</i>			
DRILLERS REMARKS:			


CODED

RECEIVED  
 MAY 27 1975

MISS. BD. OF WATER COMMISSIONERS

If well telescopes please sketch and show depths.

GROUND LEVEL

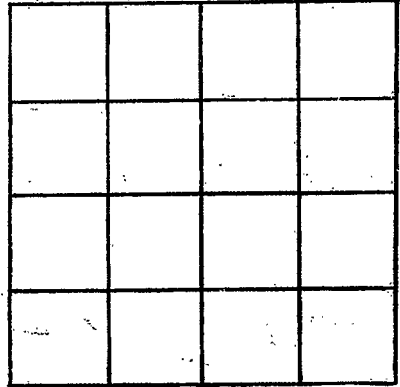

SECTION \_\_\_\_\_

Please indicate well location X.

ADDITIONAL INFORMATION

If more than one screen,  
show locations of each on sketch.