

Lirach
 1123
 7-11-75

MISSISSIPPI
 BOARD OF WATER COMMISSIONERS
 416 North State Street
 Jackson, Mississippi 39201

WATER WELL DRILLERS LOG

1975 date well completed
 JT Medlin firm name
 Lirach county well located

LANDOWNER: Gene Garner
Ripley Miss
Rt 2
 (mailing address)

description of formations encountered	from	to
Clay	0	30
Rock & Sand	30	65
blue Clay	65	100
Rock & Sand	100	200

WELL LOCATION:
 sec. 17 T 3 N R 4 E 15F
2 1/2 miles S of Buena Vista
 (distance) (direction) (nearest town)

CODED

WELL PURPOSE:
 (home, irrigation, municipal, industrial)


- WELL COMPLETION DATA:
- (1) diameter (inches) 4
 - (2) total depth (feet) 200
 - (3) static water level (feet) 70 below top of ground.
 - (4) casing P (material), 100 (depth)
 (size) if telescope see back.
 - (5) screen 1/2 (length), 10 (depth to top)
1/2 (size), (material)
 - (6) pump 1 1/2 (HP), 10 (yield gpm)
E (type power)
 - (7) electric log (yes or no) _____
 (organization running log) _____
 - (8) how well bottom plugged _____

DRILLERS REMARKS: _____

RECEIVED
 AUG 11 1975

If well telescopes please sketch and show depths.

GROUND LEVEL

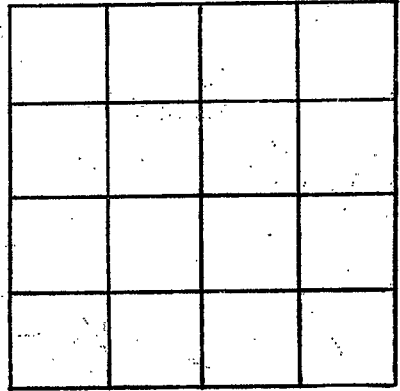

SECTION _____

Please indicate well location X.

ADDITIONAL INFORMATION

If more than one screen, show locations of each on sketch.