

TIPPAN

MISSISSIPPI BOARD OF WATER COMMISSIONERS  
416 North State Street  
Jackson, Mississippi 39201

~~UNITED~~  
Ø 24  
8-31-75

WATER WELL DRILLERS LOG

Aug 31 1975  
date well completed

~~MS~~ ~~MS~~  
J. L. McVellin  
firm name

Tippah  
~~Tipah~~  
county well located

LANDOWNER:  
Hilton Richey  
New Albany  
(mailing address)

description of formations encountered	from	to
185		

WELL LOCATION:  
sec. 3-5-5 N R 20 E  
S W  
5 miles N of Newville  
(distance) (direction) (nearest town)

185		
Clay	0	40

WELL PURPOSE:  
(home, irrigation, municipal, industrial)

Sand + clay	40	90
-------------	----	----

- WELL COMPLETION DATA:
- (1) diameter (inches) 4
  - (2) total depth (feet) 185
  - (3) static water level (feet) 125 below top of ground
  - (4) casing P 185 (material) (depth)  
4 (size) if telescope see back.
  - (5) screen 10 175 (length) (depth to top)  
4 (size) (material)
  - (6) pump 1/2 8 (HP) (yield gpm)  
E (type power)
  - (7) electric log (yes or no)
  - (organization running log)
  - (8) how well bottom plugged


Clay + rock	90	150
Sand + rock	150	185
From K&E Drilling		

DRILLERS REMARKS:

RECEIVED  
OCT 16 1975

If well telescopes please sketch and show depths.

GROUND LEVEL

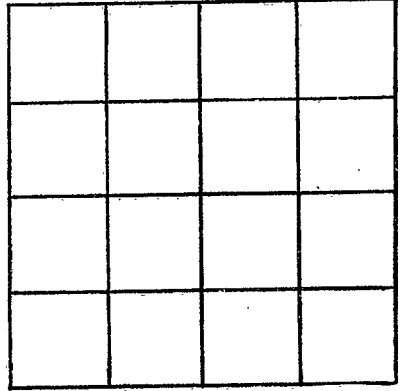

SECTION \_\_\_\_\_

Please indicate well location X.

ADDITIONAL INFORMATION

If more than one screen, show locations of each on sketch.