

Need section #

Tippah
Ø 2000
6/18/76

MISSISSIPPI
BOARD OF WATER COMMISSIONERS
416 North State Street
15F Jackson, Mississippi 39201

WATER WELL DRILLERS LOG

Tippah

6/18/76
date well completed

19 Bradley Well Drilling
firm name

county well located

LANDOWNER: Wade C. Appleton

RT #4

description of formations encountered

from to

Blue Mtn Miss
(mailing address)

CLAY 0 30
Sand + Clay mix 30 200
Clay + Rock 100 145
Sand + Rock 145 180

WELL LOCATION:

sec. T 5 N R 4 E
S W
5 miles East of Blue Mtn.
(distance) (direction) (nearest town)

WELL PURPOSE: Home
(home, irrigation, municipal, industrial)

WELL COMPLETION DATA:

- (1) diameter (inches) 4
- (2) total depth (feet) 180
- (3) static water level (feet) 120 below top of ground.
- (4) casing 4 180
(material) (depth)
- (size) if telescope see back.
- (5) screen 10 170
(length) (depth to top)
- 4 P.V.C.
(size) (material)
- (6) pump 2 8
(HP) (yield gpm)
- Elec
(type power)

(7) electric log (yes or no)

(organization running log)

(8) how well bottom plugged

DRILLERS REMARKS:


RECEIVED

JUL 28 1976

MISS. BD. OF WATER COMMISSIONERS

If well telescopes please sketch and show depths.

GROUND LEVEL

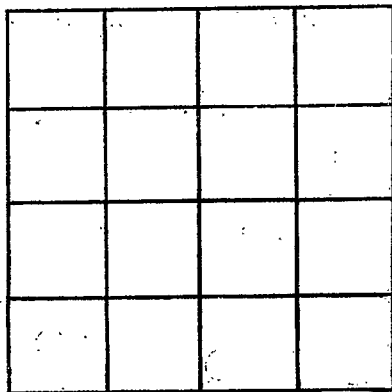

SECTION _____

Please indicate well location X.

ADDITIONAL INFORMATION

If more than one screen, show locations of each on sketch.