

Tippah
 P 200
 8/16/77

MISSISSIPPI
 BOARD OF WATER COMMISSIONERS
 416 North State Street
 Jackson, Mississippi 39201

WATER WELL DRILLERS LOG

8/16 date well completed 1977 Medlin Well Drilling firm name Tippah county well located

LANDOWNER: Johnny Davis
 Blue Mt. Ms.
 (mailing address)

description of formations encountered	from to	
Clay	0	40
Sand	40	120
Sand and Rock	120	170

WELL LOCATION:
 sec. 4 T 5 N R 4 E
 8 miles East of Blue Mt.
 (distance) (direction) (nearest town)

WELL PURPOSE:
 (Home, Irrigation, municipal, industrial)

WELL COMPLETION DATA:
 (1) diameter (inches) 4"
 (2) total depth (feet) 170 FT.
 (3) static water level (feet) 130 below top of ground.
 (4) casing PWS 170 (material) (depth)
 .010 if telescope see back. (size)
 (5) screen 10' 160' (length) (depth to top)
 4" PWS (size) (material)
 (6) pump 1/2 9 (HP) (yield gpm)
 Elec. (type power)
 (7) electric log (yes or no)
 (organization running log)
 (8) how well bottom plugged PWS Cap


DRILLERS REMARKS:

RECEIVED
 SEP 30 1977

MISS. BB. OF WATER COMM.

If well telescopes please sketch and show depths.

GROUND LEVEL

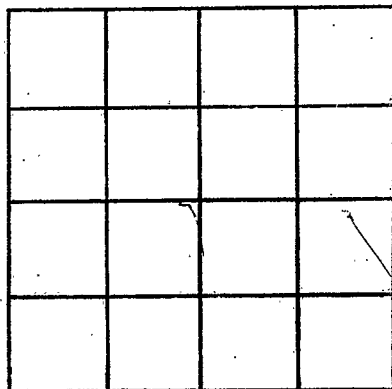

SECTION _____

Please indicate well location X.

ADDITIONAL INFORMATION

If more than one screen,
show locations of each on sketch.