

TIPPAH

0 2002

5-25-78

MAY 25 1978  
date well completed

MISSISSIPPI  
BOARD OF WATER COMMISSIONERS  
416 North State Street  
Jackson, Mississippi 39201

WATER WELL DRILLERS LOG

78 Billy R. Simpson TIPPAH  
firm name county well located

LANDOWNER:  
EDDIE Hill  
Ripley Miss  
(mailing address)

WELL LOCATION:  
sec. 8 T 5 R 4 E  
6 miles S of Ripley  
(distance) (direction) (nearest town)

WELL PURPOSE: Home  
(home, irrigation, municipal, industrial)

- WELL COMPLETION DATA:
- (1) diameter (inches) 4
  - (2) total depth (feet) 212
  - (3) static water level (feet) 118 below top of ground.
  - (4) casing PVC (material), 157 (depth),  
(size) if telescope see back.
  - (5) screen None (length), (depth to top)  
(size) (material)
  - (6) pump 1/2 (HP), 12 (yield gpm)  
ELCC (type power)
  - (7) electric log No (yes or no)  
(organization running log)
  - (8) how well bottom plugged None

description of formations encountered	from	to
<u>Surface Clay</u>	<u>0</u>	<u>4</u>
<u>SAND + CLAY</u>	<u>4</u>	<u>45</u>
<u>Blue Clay</u>	<u>45</u>	<u>49</u>
<u>SAND</u>	<u>49</u>	<u>65</u>
<u>Blue Clay + Rock</u>	<u>65</u>	<u>83</u>
<u>YELLOW Rock</u>	<u>83</u>	<u>109</u>
<u>YELLOW SAND</u>	<u>109</u>	<u>132</u>
<u>YELLOW Rock</u>	<u>132</u>	<u>157</u>
<u>Blue Clay</u>	<u>157</u>	<u>174</u>
<u>Limestone</u>	<u>157</u>	<u>174</u>
<u>Blue Clay</u>	<u>174</u>	<u>185</u>
<u>Coarse BR. SAND</u>	<u>185</u>	<u>208</u>
<u>Blue Clay</u>	<u>208</u>	<u>212</u>


DRILLERS REMARKS:

RECEIVED  
JUN 19 1978

MISS. BD. OF WATER COMMISSIONERS

If well telescopes please sketch and show depths.

GROUND LEVEL

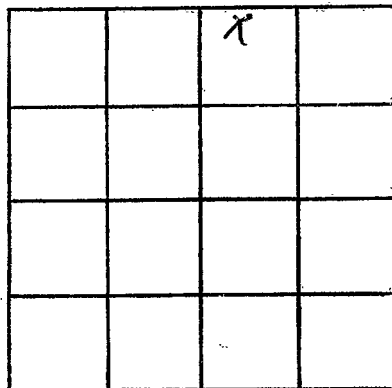

SECTION 8

Please indicate well location X.

ADDITIONAL INFORMATION

If more than one screen,  
show locations of each on sketch.