

TIPPAH  
 0 2003  
 6/04/79

MISSISSIPPI  
 BOARD OF WATER COMMISSIONERS  
 416 North State Street  
 Jackson, Mississippi 39201

WATER WELL DRILLERS LOG

6/4 1979 J T Medlin Tippah  
 date well completed firm name county well located

LANDOWNER: <u>George Stokes</u>	description of formations encountered	from	to
<u>Blue water well #4</u>		<u>Clay</u>	<u>0</u>
	<u>Rock &amp; sand</u>	<u>65</u>	<u>200</u>

(mailing address)

WELL LOCATION:  
 sec. 32 T 5 N R 4 E  
6 miles E of Blue water  
 (distance) (direction) (nearest town)

WELL PURPOSE:  
 (home, irrigation, municipal, industrial)

WELL COMPLETION DATA:

(1) diameter (inches) 4

(2) total depth (feet) 200

(3) static water level (feet) 80 below/above top of ground.

(4) casing P 140  
 (material) (depth)

\_\_\_\_\_ If telescope see back.  
 (size)

(5) screen 60 \_\_\_\_\_  
 (length) (depth to top)

\_\_\_\_\_ (size) \_\_\_\_\_ (material)

(6) pump 1/2 6  
 (HP) (yield gpm)

E  
 (type power)

(7) electric log \_\_\_\_\_  
 (yes or no)

\_\_\_\_\_ (organization running log)

(8) how well bottom plugged open

Miss. Board of Water Comm.


AUG 10 1979

RECEIVED

DRILLERS REMARKS:

If well telescopes please sketch and show depths.

GROUND LEVEL

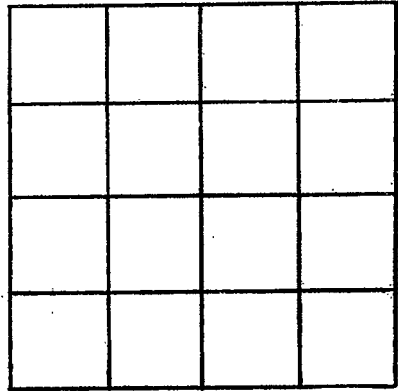

SECTION \_\_\_\_\_

Please indicate well location X.

ADDITIONAL INFORMATION

If more than one screen,  
show locations of each on sketch.