

MISSISSIPPI DEPARTMENT OF NATURAL RESOURCES

Bureau of Land and Water Resources

Southport Mall

P.O. Box 10631

Jackson, Mississippi 39209

WATER WELL DRILLERS LOG

Jipah
 O
 2000

4-24-1982 ST Madlin Tipah
 date well completed firm name county well located

LANDOWNER:
 Mark Hodges
 RA 2 Blue Mt. W.
 (mailing address)

description of formations encountered
 from to
 sand - clay - 0 120

WELL LOCATION:
 sec 21 T 5 N R 4 E
 3 miles W of DUMAS
 (distance) (direction) (nearest town)

clay - rock - 120 - 200
 sand - 200 - 250

WELL PURPOSE:
 (home, irrigation, municipal, industrial)

WELL COMPLETION DATA:

(1) diameter (inches) 4

(2) total depth (feet) 260

(3) static water level (feet) 150 below above top of ground.

(4) casing PVC 260 (material) (depth)
 if telescope see back.

(5) screen 10' 250 (length) (depth to top)
 4 PVC (size) (material)

(6) pump 3/4 12 (HP) (yield gpm)
 EIP (type power)

(7) electric log (yes or no)

(organization running log)

DEPT. OF NATURAL RESOURCES
 BUREAU OF LAND & WATER RESOURCES

(8) how well bottom plugged CAP


JUN 28 1982

DRILLERS REMARKS:

RECEIVED

If well telescopes please sketch and show depths.

GROUND LEVEL

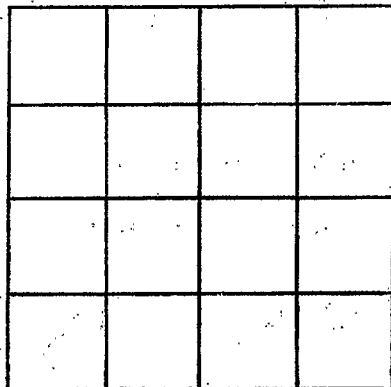

SECTION _____

Please indicate well location X.

ADDITIONAL INFORMATION

If more than one screen,
show locations of each on sketch.