

MISSISSIPPI DEPARTMENT OF NATURAL RESOURCES

Bureau of Land and Water Resources

Southport Mall

P.O. Box 10631

Jackson, Mississippi 39209

WATER WELL DRILLERS LOG

TIPPAH
 2007

2-19-87
 date well completed

Wilson Well Co. Inc.
 firm name

Jasper
 county well located

LANDOWNER: James Lewis
 Rt 1 Box 32A
 Ripley, Mo.
 (mailing address)

WELL LOCATION:
 sec. 5 T. 5 N R. 4 E
 6 miles SE of Ripley
 (distance) (direction) (nearest town)

WELL PURPOSE:
 (home, irrigation, municipal, industrial)

WELL COMPLETION DATA:

- (1) diameter (inches) 4
- (2) total depth (feet) 123
- (3) static water level (feet) 87' below top of ground.
- (4) casing PVC, 113 (material) (depth)
 4 (size) if telescope see back.
- (5) screen 10, 113 (length) (depth to top)
 4, PVC (size) (material)
- (6) pump 3/4, 10 (HP) (yield gpm)
 Elect (type power)
- (7) electric log No. (yes or no)

(organization running log)

(8) how well bottom plugged 4" Pipecap

description of formations encountered	from	to
Red Sand	0	5
Red Clay	5	15
Red Clay & Red Sand	15	30
Red Clay	30	43
Rock	43	45
Blue clay & Rock	45	75
Rock & Yellow Clay	75	90
Grey Sand & Rock	90	105
Grey Sand	105	120
Grey Sand/Rock & Clay	120	123

REGISTERED


MAR 12 1987

Department of Natural Resources
 Bureau of Land & Water Resources

DRILLERS REMARKS:

If well telescopes please sketch and show depths.

GROUND LEVEL

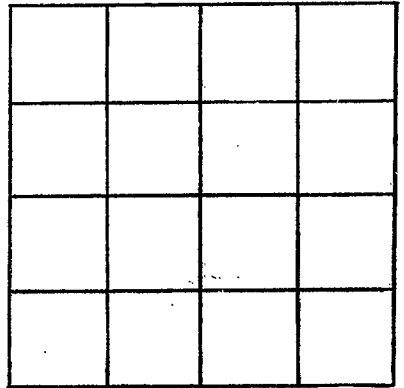

SECTION _____

Please indicate well location X.

ADDITIONAL INFORMATION

If more than one screen, show locations of each on sketch.