

MISSISSIPPI DEPARTMENT OF ENVIRONMENTAL QUALITY
Bureau of Land and Water Resources

P. O. Box 10631
Jackson, MS 39289-0631
WATER WELL DRILLERS' LOG

COUNTY WELL LOCATED TIPAH	
WELL NUMBER Φ	CODED
DATE WELL COMPLETED 2010 5-27-92	

PERMIT NUMBER
NAME OF DRILLING FIRM Wilson Wells, Inc.
Whiteville, TN. 38075

NAME & MAILING ADDRESS OF LANDOWNER DOYLE EATON Rt. 1, Box 143A Blue Mountain, Ms. 38610			
WELL LOCATION:	SEC	TOWNSHIP	RANGE
	17	5^N	4^W
DISTANCE	DIRECTION	NEAREST TOWN	
_____ Miles	_____ of _____		
OTHER LANDMARK			
WELL PURPOSE: <input checked="" type="radio"/> Home Irrigation, <input type="radio"/> Municipal, <input type="radio"/> Industrial, <input type="radio"/> Fish Pond, etc.			


PUMP DATA			
PUMP TYPE (Circle One): <input checked="" type="radio"/> Submersible, <input type="radio"/> Turbine, <input type="radio"/> Jet <input type="radio"/> Flowing Well, Other (Describe) _____			
POWER TYPE (Circle One): <input checked="" type="radio"/> Electric, <input type="radio"/> Tractor, <input type="radio"/> Diesel, <input type="radio"/> Gasoline, <input type="radio"/> Butane, Other (Describe) _____ H/P _____			
Pump Capacity (GPM)	No. of Stages	Setting Depth	
10	12	160 FT.	
PUMP TEST			
Well yielded 10 GPM with a drawdown of _____ ft. after _____ hours of pumping			

WELL DATA		
Well Depth 185	Casing Diameter (In.) 4"	Casing Length (Ft.) 165
Type of Casing Pvc.	Hole Depth 175	Depth to Static Water Level 95
TYPE OF COMPLETION: (Circle One or More): <input checked="" type="radio"/> Gravel Packed, <input type="radio"/> Underreamed, <input type="radio"/> Telescoped, <input type="radio"/> Natural Development, <input type="radio"/> Open Hole, <input type="radio"/> Other (Describe) _____		
Top of Lap Pipe or Reduction in Casing		
FEET <input type="checkbox"/> IF TELESCOPED OR MORE THAN ONE SCREEN: USE BACK PAGE		

LOG DATA	
TYPE OF LOG RUN (Circle One): <input type="radio"/> Electric, <input type="radio"/> Gamma Ray, <input type="radio"/> Density, <input type="radio"/> Sonic, <input checked="" type="radio"/> Neutron, Other (Describe) _____	
Name of Organization Running Log	

SCREEN DATA		
Diameter - Inches 4"	Length - Feet 10	Slot Size - Inches .010
Screen Type Pvc.	Depth to Bottom - Feet 115	


GEOLOGIC DATA (Office Use Only)			
Surface Elev.	Geologic Unit	Unit Thickness	Depth to Top
Subs. SWL	Date	Analysis	Aquifer Test
Driller's Remarks			

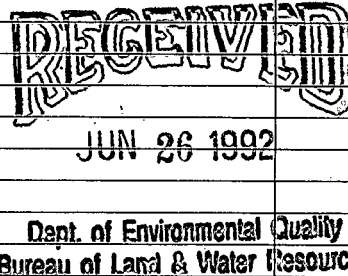DESCRIPTION OF FORMATIONS ENCOUNTERED	FROM	TO	FORMATIONS (Continued)	FROM	TO
Red Sand & Clay	0	20			
Red Sand	20	60			
Red & Blue Clay	60	80			
Red Clay	80	105			
Red Clay & Rock	105	115			
Rock	115	120			
Blue Clay & Rock	130	135			
Gray Sand	155	180			

IF MORE SPACE IS NEEDED, USE BACK

If well telescopes please
sketch and show depths.

GROUND LEVEL

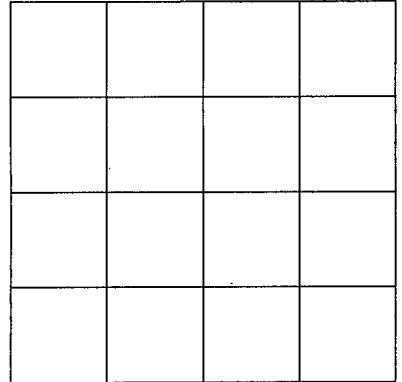

SECTION _____

Please indicate well location X.

ADDITIONAL INFORMATION

If more than one screen,
show location of each on sketch.