

TIPPAH
P 15
9-15-72

MISSISSIPPI
BOARD OF WATER COMMISSIONERS
416 North State Street
Jackson, Mississippi 39201

WATER WELL DRILLERS LOG

CODED

9-15 1972 Bondar Well Drilling Tippah
date well completed firm name county well located

LANDOWNER: Guy Strouse

description of formations encountered from to

Ripley Miss
(mailing address)

Red clay	0	34
Blue clay	34	372
Water sand	372	425

WELL LOCATION:
sec. 34 T 5 N R 5 E
13 miles West of Brownville
(distance) (direction) (nearest town)

WELL PURPOSE: Home
(home, irrigation, municipal, industrial)

WELL COMPLETION DATA:

- (1) diameter (inches) 4
- (2) total depth (feet) 425
- (3) static water level (feet) 110 below above top of ground.
- (4) casing Steel, 42
(material) (depth)
 if telescope see back.
(size)
- (5) screen none
(length) (depth to top)
 (size) (material)
- (6) pump 2 5
(HP) (yield gpm)
Electric pump
(type power)
- (7) electric log no
(yes or no)
 (organization running log)
- (8) how well bottom plugged open

CODED


DRILLERS REMARKS:

OCT 17 1972

MISSISSIPPI BOARD OF WATER COMMISSIONERS

If well telescopes please
sketch and show depths.

GROUND LEVEL

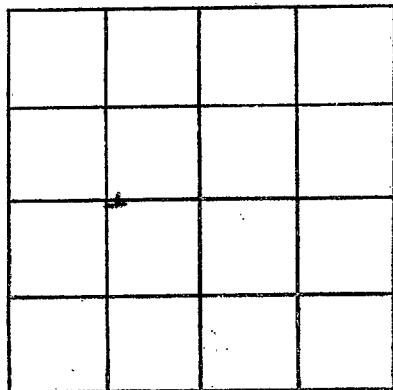

SECTION _____

Please indicate well location X.

ADDITIONAL INFORMATION

If more than one screen,
show locations of each on sketch.