

TIPPAH
P 16
9-27-72

MISSISSIPPI
BOARD OF WATER COMMISSIONERS
416 North State Street
Jackson, Mississippi 39201

WATER WELL DRILLERS LOG

CODED

9-27 172 Bonds Well Drilling Tippha
date well completed firm name county well located

LANDOWNER: R. D. Strump

description of formations encountered from to

Pipes, Miss (mailing address)

Red Clay 0 18
Blue Clay 18 387
Water Sand 387 440

WELL LOCATION:
sec. 34 T. 25 N. R. 5 E
13 miles West of Booneville
(distance) (direction) (nearest town)

WELL PURPOSE: Home
(home, irrigation, municipal, industrial)

WELL COMPLETION DATA:

- (1) diameter (inches) 4
- (2) total depth (feet) 440
- (3) static water level (feet) 116 below above top of ground.
- (4) casing Steel 21 (material) (depth)
- (size) If telescope see back.
- (5) screen none (length) (depth to top)
- (size) (material)
- (6) pump 2 4 (HP) (yield gpm)
- (type power)
- (7) electric log no (yes or no)
- (organization running log)
- (8) how well bottom plugged Open

CODED


OCT 17 1972

DRILLERS REMARKS:

MISS. BU. OF WATER
REGISTERED

If well telescopes please sketch and show depths.

GROUND LEVEL

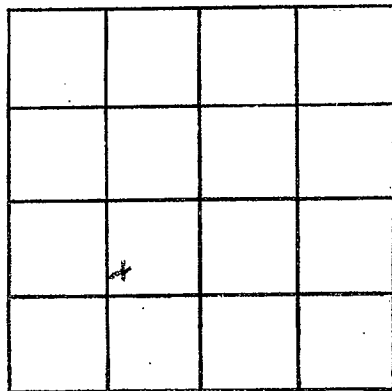

SECTION _____

Please indicate well location X.

ADDITIONAL INFORMATION

If more than one screen, show locations of each on sketch.