

TIPPAN
P 17
9-6-74

MISSISSIPPI
BOARD OF WATER COMMISSIONERS
416 North State Street
Jackson, Mississippi 39201

CODED

WATER WELL DRILLERS LOG

9-6 date well completed 1974 Bonds W. Old Drilling firm name Tippah county well located


LANDOWNER:	description of formations encountered	from	to
Harold Keykandell			
Ripley Miss. (mailing address)	Blue clay	29	313
	Water Sand	313	367

WELL LOCATION:
sec. 1 T. 5 N. R. 5 E.
9 miles W of Bonneville
(distance) (direction) (nearest town)

WELL PURPOSE: Home
(home, irrigation, municipal, industrial)

- WELL COMPLETION DATA:
- (1) diameter (inches) 4"
 - (2) total depth (feet) 367'
 - (3) static water level (feet) 150 ^{below} _{above} top of ground.
 - (4) casing Steel, 32'6"
(material) (depth)
 - If telescope see back.
(size)
 - (5) screen None
(length) (depth to top)
 - (size) (material)
 - (6) pump 3/4 10
(HP) (yield gpm)
 - Sub
(type power)
 - (7) electric log NO
(yes or no)
 - (organization running log)
 - (8) how well bottom plugged open

DRILLERS REMARKS:

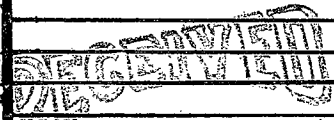


OCT - 1 1974

MISS. BD. OF WATER COMMISSIONERS

If well telescopes please sketch and show depths.

GROUND LEVEL

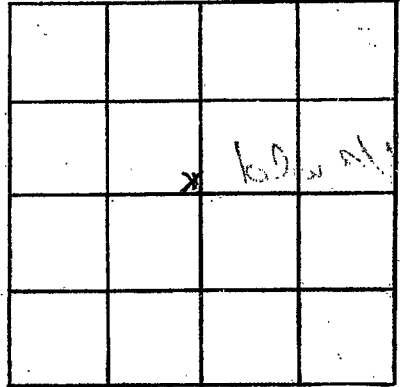

SECTION _____

Please indicate well location X.

ADDITIONAL INFORMATION

If more than one screen, show locations of each on sketch.