

TIPPAN
 P18
 12/75
 Elog #21

MISSISSIPPI
 BOARD OF WATER COMMISSIONERS
 416 North State Street
 Jackson, Mississippi 39201

CODED

WATER WELL DRILLERS LOG

December 1975 19 Herndon Well & Supply, Inc. Tippah
 date well completed firm name county well located

LANDOWNER: Dumas-Pine Grove
 Water Association, Inc.
 Ripley, MS 38663
 (mailing address)

WELL LOCATION:
 sec. 18 T 5xxx S R 5 E xxx
 (distance) miles (direction) of (nearest town)

WELL PURPOSE: Community
 (home, irrigation, municipal, industrial)

WELL COMPLETION DATA:
 (1) diameter (inches) 10 x 6
 (2) total depth (feet) 765
 (3) static water level (feet) 323 below top of ground. xxx
 (4) casing Steel, 700' (material) (depth)
 10 (size) if telescope see back.
 (5) screen 60 760 (length) (depth to top)
 6" Stainless (size) (material)
 (6) pump 50 210 (HP) (yield gpm)
 Elec. (type power)
 (7) electric log Yes. (yes or no)
 USGS (organization running log)
 (8) how well bottom plugged BW

description of formations encountered	from	to
15 Ft Red Clay: 15 Sand	0	30
Sand	30	60
Sand	60	90
Blue Gumbo & Streak. Sand	90	120
Blue Gumbo	120	150
Blue Gumbo	150	180
Streaked Gumbo and Sand		
Rock (6" 2 210)	180	210
Blue Gumbo	210	600
Streaked sand and gumbo	600	630
Blue Gumbo	630	700
Sand	700	750
10 Ft sand, 20 ft		
Blue Gumbo	750	780
Streaked Sand and Blue Gumbo	780	810
Sand	810	840
Streaked sand & Gumbo	840	870

CODED


RECEIVED
 FEB 27 1976

DRILLERS REMARKS:

If well telescopes please sketch and show depths.

(X)

GROUND LEVEL

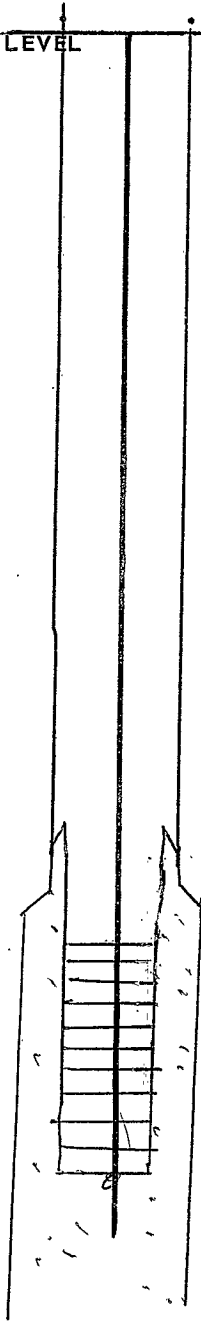

If more than one screen, show locations of each on sketch.

	X		

SECTION _____

Please indicate well location X.

ADDITIONAL INFORMATION

325 BAGS CEMENT

7 CU YD GRAVEL

SCREEN: DEPTH 1030