

Tippah  
 P 2001  
 9-26-80

MISSISSIPPI  
 BOARD OF WATER COMMISSIONERS  
 416 North State Street  
 Jackson, Mississippi 39201

WATER WELL DRILLERS LOG

Sept 26 1980 date well completed  
 JST Morris firm name  
 TIPPAAH county well located

LANDOWNER: Michael Adams  
 Dumas MS.  
 (mailing address)

description of formations encountered	from	to
red clay	0	30
sand & clay	30	60
sand	60	140
clay	140	180

WELL LOCATION:  
 sec. 35 T 5 N R. 10 E  
 3 miles SE of Dumas  
 (distance) (direction) (nearest town)

WELL PURPOSE:  
 (home, irrigation, municipal, industrial)

- WELL COMPLETION DATA:
- (1) diameter (inches) 4
  - (2) total depth (feet) 180
  - (3) static water level (feet) 90 below top of ground.
  - (4) casing PVC 180 (material) (depth)
  - (size) If telescope see back.
  - (5) screen 50 120 (length) (depth to top)
  - 4 PVC (size) (material)
  - (6) pump 1/2 10 (HP) (yield gpm)
  - C (type power)
  - (7) electric log (yes or no)
  - (organization running log)
  - (8) how well bottom plugged Cap

DRILLERS REMARKS:


DEPT. OF NATURAL RESOURCES  
 BUREAU OF LAND & WATER RESOURCES

OCT 28 1980

RECEIVED

If well telescopes please sketch and show depths.

GROUND LEVEL

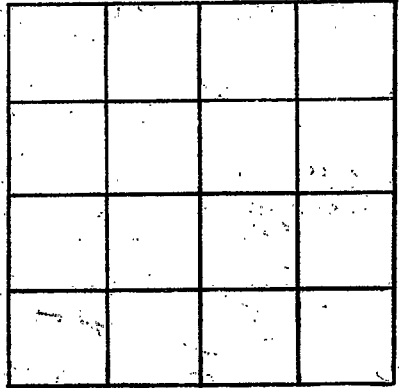

SECTION \_\_\_\_\_

Please indicate well location X.

ADDITIONAL INFORMATION

If more than one screen,  
show locations of each on sketch.