

71 5

MISSISSIPPI
BOARD OF WATER COMMISSIONERS
416 North State Street
Jackson, Mississippi 39201

CODED

CODED

WATER WELL DRILLERS LOG

Tishomingo
A 4
6-69

6-20 1969 Faires Well Supply Tishomingo
 date well completed firm name county well located


LANDOWNER: <u>Oscar Jones</u>	description of formations encountered	from	to
<u>Route 1</u>			
<u>Burnsville, Miss</u> (mailing address)	<u>Red dirt Sand & clay</u>	<u>0</u>	<u>75</u>
WELL LOCATION: sec. <u>35</u> T. <u>2</u> N. R. <u>9</u> E <u>3</u> miles <u>71</u> of <u>Burnsville</u> (distance) (direction) (nearest town)	<u>Sand in bottom</u>		
WELL PURPOSE: (home, irrigation, municipal, industrial)			
WELL COMPLETION DATA:			
(1) diameter (inches) <u>4</u>			
(2) total depth (feet) <u>75</u>			
(3) static water level (feet) <u>30</u> below top of ground.			
(4) casing <u>PVC</u> <u>70</u> (material) (depth)			
<u>5/2</u> if telescope see back. (size)			
(5) screen <u>5'</u> <u>PVC</u> (length) (depth to top) (material)			
<u>4"</u> <u>PVC</u> (size) (material)			
(6) pump _____ (HP) (yield gpm)			
(type power)			
(7) electric log _____ (yes or no)			
(organization running log)			
(8) how well bottom plugged _____			
DRILLERS REMARKS: <u>Installed in own pump</u>			

SEP - 3 1969

MISS. DE. OF
WATER COMMISSIONERS

If well telescopes please sketch and show depths.

GROUND LEVEL

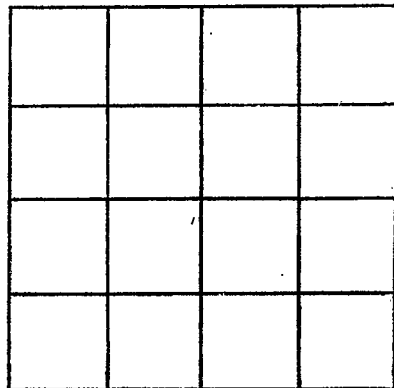

SECTION _____

Please indicate well location X.

ADDITIONAL INFORMATION

If more than one screen,
show locations of each on sketch.