

Lishomingo  
A5  
9-1-69

MISSISSIPPI  
BOARD OF WATER COMMISSIONERS CODED  
416 North State Street  
Jackson, Mississippi 39201

WATER WELL DRILLERS LOG

Sept 1 1969 Hughes well Drilling Liana  
date well completed firm name county well located

LANDOWNER: <u>Dorcy Stovall</u>	description of formations encountered	from	to
<u>Burnsville miss</u> (mailing address)			

WELL LOCATION:  
sec. 35 T 2 S R 9 E  
1 miles N of Burns.  
(distance) (direction) (nearest town)

WELL PURPOSE: Home  
(home, irrigation, municipal, industrial)

- WELL COMPLETION DATA:
- (1) diameter (inches) 6 5/8
  - (2) total depth (feet) 125
  - (3) static water level (feet) 70 below top of ground.
  - (4) casing Galv, 125,  
(material) (depth)  
(size) if telescope see back.
  - (5) screen \_\_\_\_\_,  
(length) (depth to top)  
(size) (material)
  - (6) pump \_\_\_\_\_,  
(HP) (yield gpm)  
(type power)
  - (7) electric log \_\_\_\_\_  
(yes or no)  
(organization running log)
  - (8) how well bottom plugged \_\_\_\_\_


DRILLERS REMARKS:  
Install 1/2 HP Super.  
pump 42 gal storage tank.  
100 ft Deep

SEP 3 1969

MISS. BD. OF  
WATER COMMISSIONERS

If well telescopes please sketch and show depths.

GROUND LEVEL

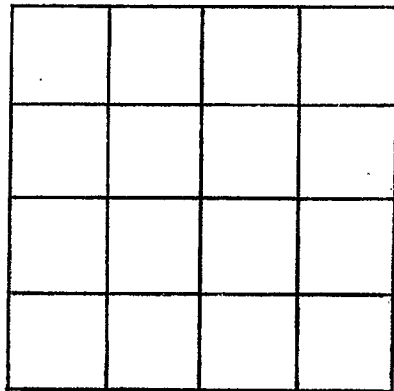

SECTION 35

Please indicate well location X.

ADDITIONAL INFORMATION

If more than one screen, show locations of each on sketch.