

Tishomingo
A 6
8-30-69

MISSISSIPPI
BOARD OF WATER COMMISSIONERS
416 North State Street
Jackson, Mississippi 39201

CODED

WATER WELL DRILLERS LOG

CODED

8-30 19 69 FAIRES WELL SUPPLY TISHOMINGO
date well completed firm name county well located

LANDOWNER: Dallas Jet Jones
Rte. 1, Burnsville

description of formations encountered	from	to
Red clay & sand	0	130
Red Clay & Sand - Blue Clay Gray Sand	0	30
	30	100
	100'	130'

(mailing address)

WELL LOCATION:

sec. 33 T 2 N R 9 E
S W
1 miles N.W. of Burnsville
(distance) (direction) (nearest town)

WELL PURPOSE:
(home, irrigation, municipal, industrial)

WELL COMPLETION DATA:


- (1) diameter (inches) 4
- (2) total depth (feet) 130
- (3) static water level (feet) 70 below top of ground.
- (4) casing P.V.C. 125' (material), (depth)
- (size) if telescope see back.
- (5) screen 5' (length), (depth to top) 4" PVC (size), (material)
- (6) pump 3/4 (HP) 5 (yield gpm) Elec. (type power)
- (7) electric log (yes or no) (organization running log)
- (8) how well bottom plugged

OCT 17 1969
MISS. BD. OF WATER COMM.

DRILLERS REMARKS:

If well telescopes please sketch and show depths.

GROUND LEVEL

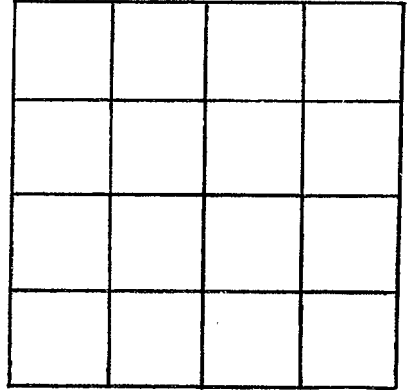

SECTION _____

Please indicate well location X.

ADDITIONAL INFORMATION

If more than one screen, show locations of each on sketch.