

CODED

MISSISSIPPI
BOARD OF WATER COMMISSIONERS
416 North State Street
Jackson, Mississippi 39201

WATER WELL DRILLERS LOG

Jsh
A 7
9-10-69

Sept 10 19*69* *Hugon well D* *Liam.*
date well completed firm name county well located

LANDOWNER: *Dorothy Burnett*

Road 1

Burnsville miss
(mailing address)

| description of formations encountered | from | to |
|---------------------------------------|------------|------------|
| <i>⊙ sand</i> | <i>0</i> | <i>60</i> |
| <i>Clay sand</i> | <i>60</i> | <i>100</i> |
| <i>white sand</i> | <i>100</i> | <i>125</i> |

WELL LOCATION:

sec. *35* T *2* R *9*
2 miles *N* of *BURNS*
(distance) (direction) (nearest town)

WELL PURPOSE: *Home*
(home, irrigation, municipal, industrial)

WELL COMPLETION DATA:

(1) diameter (inches) *6 1/2*

(2) total depth (feet) *125*

(3) static water level (feet) *60* below above top of ground.

(4) casing *Galv.* *120*
(material) (depth)

(size) if telescope see back.

(5) screen (length) (depth to top)

(size) (material)

(6) pump *1/2* *Subs*
(HP) (yield gpm)

220
(type power)

(7) electric log (yes or no)

(organization running log)

(8) how well bottom plugged *Small*

DRILLERS REMARKS:


Special 1/2 HP pump

DEC - 3 1969

MISS. BD. OF
WATER COMMISSIONERS

If well telescopes please sketch and show depths.

GROUND LEVEL

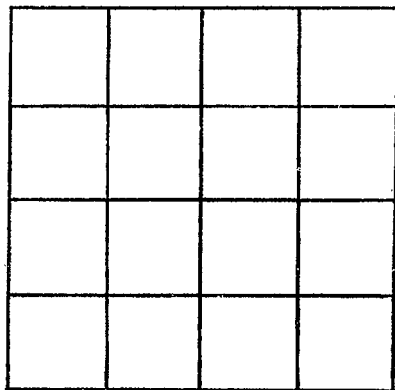

SECTION _____

Please indicate well location X.

ADDITIONAL INFORMATION

If more than one screen,
show locations of each on sketch.