

*Jisk*  
*A 8*  
*10-10-69*

MISSISSIPPI  
 BOARD OF WATER COMMISSIONERS  
 416 North State Street  
 Jackson, Mississippi 39201

CODED

WATER WELL DRILLERS LOG

*000 10* 19 *69* *Hughes well #* *Lian*  
 date well completed firm name county well located

LANDOWNER: *Benny Taylor*

description of formations encountered	from	to
<i>pond</i>	<i>0</i>	<i>120</i>
<i>Redd clay</i>	<i>120</i>	<i>220</i>
<i>white sand</i>	<i>220</i>	<i>225</i>

*Row 3*

*Burnsville miss*  
 (mailing address)

WELL LOCATION:  
 sec. *34* T. *1* N. *9* E.  
*S* miles *N* of *BURNSVILLE*  
 (distance) (direction) (nearest town)

WELL PURPOSE: *farm*  
 (home, irrigation, municipal, industrial)

WELL COMPLETION DATA:

- (1) diameter (inches) *6 1/2*
- (2) total depth (feet) *225*
- (3) static water level (feet) *170* below above top of ground.
- (4) casing *Galv*, *175*,  
 (material) (depth)  
 (size) if telescope see back.
- (5) screen \_\_\_\_\_  
 (length) (depth to top)  
 (size) (material)
- (6) pump *1/2* \_\_\_\_\_  
 (HP) (yield gpm)  
 (type power)
- (7) electric log \_\_\_\_\_  
 (yes or no)  
 (organization running log)
- (8) how well bottom plugged \_\_\_\_\_


DRILLERS REMARKS:  
*dr installed 1/2 HP pump*

DEC - 9 1969

MISS. BD. OF  
 WATER RES. CONTROL

If well telescopes please sketch and show depths.

GROUND LEVEL

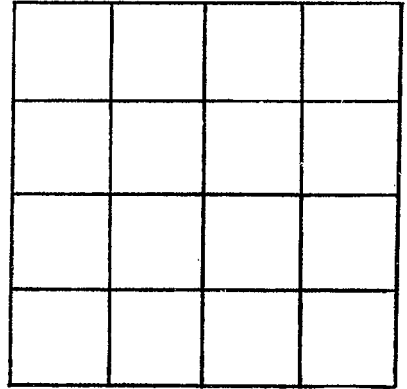

SECTION \_\_\_\_\_

Please indicate well location X.

ADDITIONAL INFORMATION

If more than one screen,  
show locations of each on sketch.