

TISHOMINGO

A 9

9-11-70

MISSISSIPPI BOARD OF WATER COMMISSIONERS  
416 North State Street  
Jackson, Mississippi 39201

**CODED**

WATER WELL DRILLERS LOG

Tishomingo

~~ALCOON~~

9-11  
date well completed

1970

FAIRES WELL SUPPLY

firm name

county well located

LANDOWNER: Mrs. D. W. Childs

Rte 1

description of formations encountered

from

to

Burnsville, Miss.

(mailing address)

Red clay & sand

0

5560

Fine gray sand

66

80

WELL LOCATION:

sec. 34 T. 2 N. R. 9 E.

2 miles N.W. of Burnsville  
(distance) (direction) (nearest town)

WELL PURPOSE:

(home, irrigation, municipal, industrial)

WELL COMPLETION DATA:

- (1) diameter (inches) 4"
- (2) total depth (feet) 80
- (3) static water level (feet) 35 below above top of ground.
- (4) casing PVC 75 (material) (depth)
- (size) if telescope see back.
- (5) screen 5' (length) (depth to top)  
4" PVC (size) (material)
- (6) pump 3/4 3 (HP) (yield gpm)  
Elec. (type power)
- (7) electric log (yes or no)

(organization running log)

(8) how well bottom plugged

**CODED**


NOV 19 1970

MISS. BD. OF WATER COMMISSIONERS

DRILLERS REMARKS:

If well telescopes please sketch and show depths.

GROUND LEVEL

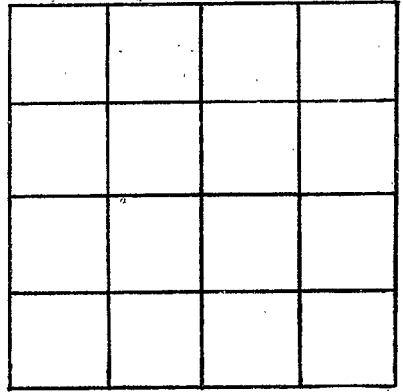

SECTION \_\_\_\_\_

Please indicate well location X.

ADDITIONAL INFORMATION

If more than one screen, show locations of each on sketch.