

TISHOMINGO
A 10
6-23-71

MISSISSIPPI
BOARD OF WATER COMMISSIONERS
416 North State Street
Jackson, Mississippi 39201

CODED

WATER WELL DRILLERS LOG

6-23 date well completed 71 Bond Well Driller firm name Tishomingo Miss. county well located

LANDOWNER: Norman Cooper
Burnsville Miss
(mailing address)

description of formations encountered	from	to
Red clay	12	46
Water sand	46	71

WELL LOCATION:
sec. 36 T 2 N R 9 E
3 miles North of Burnsville
(distance) (direction) (nearest town)

WELL PURPOSE: Home
(home, irrigation, municipal, industrial)

- WELL COMPLETION DATA:
- (1) diameter (inches) 4
 - (2) total depth (feet) 71
 - (3) static water level (feet) 16 below above top of ground.
 - (4) casing 8.25 71
(material) (depth)
(size) if telescope see back.
 - (5) screen Prepacked Casin
(length) (depth to top)
4 Steel
(size) (material)
 - (6) pump HPM 1/2
(type power) (yield gpm)
 - (7) electric log no
(yes or no)
(organization running log)
 - (8) how well bottom plugged plug

CODED


JUL 14 1971

DRILLERS REMARKS:

MISS. BD. OF
WATER COMMISSIONERS

If well telescopes please sketch and show depths.

GROUND LEVEL

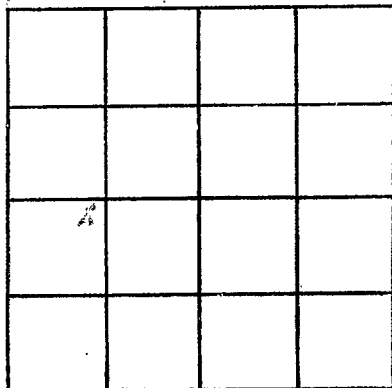

SECTION _____

Please indicate well location X.

ADDITIONAL INFORMATION

If more than one screen, show locations of each on sketch.