

TISHOMIGO
A II
6-16-72

MISSISSIPPI
BOARD OF WATER COMMISSIONERS
416 North State Street
Jackson, Mississippi 39201

WATER WELL DRILLERS LOG

6-16 date well completed 72 Bond Well Drilling firm name Tishomingo county well located

LANDOWNER: J. A. Tucker

Burrville, Miss. (mailing address)

description of formations encountered	from	to
	Red clay	0
Red sand	23	54
Water sand	54	110

WELL LOCATION:
sec. 28 T 2 N R 9 E
S W
2 miles North of Burrville
(distance) (direction) (nearest town)

WELL PURPOSE: Home
(home, irrigation, municipal, industrial)

- WELL COMPLETION DATA:
- (1) diameter (inches) 4
 - (2) total depth (feet) 110
 - (3) static water level (feet) 40 below top of ground.
 - (4) casing Steel, 110 (material) (depth)
 - (size) If telescope see back.
 - (5) screen 10' length, 110' depth to top (material)
 - (size) (material)
 - (6) pump 3/4 HP, 8 (yield gpm)
 - Elect pump (type power)
 - (7) electric log yes (yes or no)
 - (organization running log)
 - (8) how well bottom plugged plugged


DRILLERS REMARKS:

JUN 5 1972

MISS. DIV. OF WATER CONTROL

If well telescopes please sketch and show depths.

GROUND LEVEL

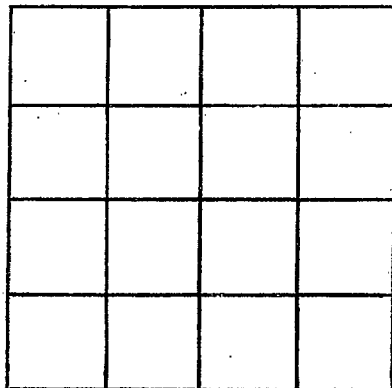

SECTION _____

Please indicate well location X.

ADDITIONAL INFORMATION

If more than one screen, show locations of each on sketch.