

**TISHOMINGO**  
**A 12**  
**4-2-73**

MISSISSIPPI  
 BOARD OF WATER COMMISSIONERS  
 416 North State Street  
 Jackson, Mississippi 39201  
**WATER WELL DRILLERS LOG**

**CODED**

4-2 1973 Bonds Well Drilling Tishomingo  
 date well completed firm name county well located


LANDOWNER: <u>Wilbur Boothe</u>	description of formations encountered	from	to
<u>Burnsville, Mo.</u> (mailing address)	<u>Red clay</u> <u>yellow sand</u> <u>Blue clay</u> <u>Water sand</u>	<u>0</u> <u>52</u> <u>142</u> <u>245</u>	<u>52</u> <u>142</u> <u>245</u> <u>273</u>
WELL LOCATION: sec. <u>28</u> T. <u>2</u> N R. <u>9</u> E <u>3</u> miles <u>North</u> of <u>Burnsville</u> (distance) (direction) (nearest town)			
WELL PURPOSE: <u>Home</u> (home, irrigation, municipal, industrial)			
WELL COMPLETION DATA:			
(1) diameter (inches) <u>4</u>			
(2) total depth (feet) <u>273</u>			
(3) static water level (feet) <u>110</u> <sup>below</sup> above top of ground.			
(4) casing <u>steel</u> <u>173</u> (material) (depth)			
_____ if telescope see back. (size)			
(5) screen <u>None</u> (length) (depth to top)			
_____ (size) _____ (material)			
(6) pump <u>3/4</u> <u>5</u> (HP) (yield gpm)			
<u>sub.</u> (type power)			
(7) electric log <u>NO</u> (yes or no)			
_____ (organization running log)			
(8) how well bottom plugged <u>open</u>			
DRILLERS REMARKS:			

**CODED**

INSTRUMENTS  
 2 1/2"

If well telescopes please sketch and show depths.

GROUND LEVEL

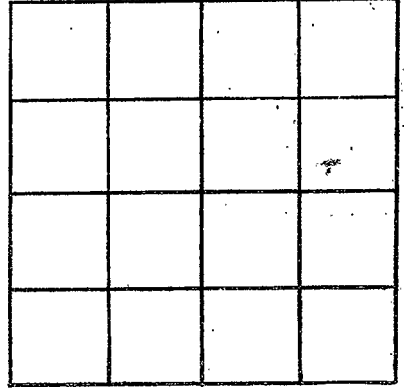

SECTION \_\_\_\_\_

Please indicate well location X.

ADDITIONAL INFORMATION

If more than one screen, show locations of each on sketch.