

Tishomingo
 B5
 H-68
 USGS

MISSISSIPPI
 BOARD OF WATER COMMISSIONERS
 416 North State Street
 Jackson, Mississippi 39201

WATER WELL DRILLERS LOG

April 1968 Miller Drilling Co Tishomingo
 date well completed firm name county well located

LANDOWNER: SHORT-COLEMAN
 PARK UTILITY DISTRICT
 (mailing address)


description of formations encountered	from	to
yellow clay	0	40
Brown sand & clay	40	100
Red sand & clay	100	115
White, cherty rock soft	115	133
Brown cherty rock soft	133	159
Brown Cherty rock hard, dense	159	161
Brown, sharp, broken rock & gravel water here	161	289
Brown sand rock	289	290
Chattanooga shale black	290	315
blue lime, hard	315	322

WELL LOCATION: NW NW NE
 sec. 1 T. 2 N. R. 10 E
 (distance) miles (direction) of (nearest town)

WELL PURPOSE: UTILITY DIST
 (home, irrigation, municipal, industrial)

WELL COMPLETION DATA:

(1) diameter (inches) 6
 (2) total depth (feet) 322
 (3) static water level (feet) 154 (below/above top of ground)
 (4) casing Steel 160 (material) (depth)
 6 1/4 ID if telescope see back. (size)
 (5) screen NONE (length) (depth to top)
 (size) (material)
 (6) pump NONE (HP) (yield gpm)
 (type power)
 (7) electric log YES (yes or no)
 USGS (organization running log)
 (8) how well bottom plugged

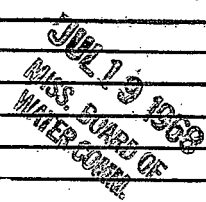


DRILLERS REMARKS: Test well
 ONLY. Permeant
 well to be drilled
 IN AUGUST 68



If well telescopes please
sketch and show depths.

GROUND LEVEL

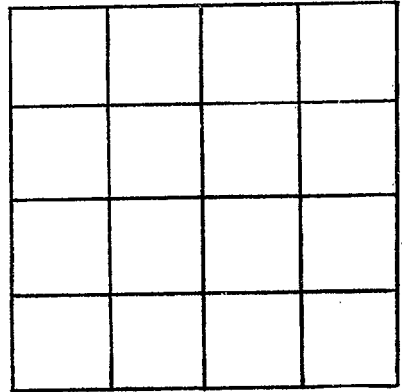

SECTION _____

Please indicate well location X.

ADDITIONAL INFORMATION

If more than one screen,
show locations of each on sketch.