

**MISSISSIPPI
BOARD OF WATER COMMISSIONERS**
416 North State Street
Jackson, Mississippi 39201

WATER WELL DRILLERS LOG

Tishomingo
B 6
6-68
KS65

JUNE 11, 1968 19 Miller Drilling Co Tishomingo
date well completed firm name county well located

LANDOWNER: NORTH
CROSSROADS UTILITY
DISTRICT
(mailing address)

description of formations encountered	from	to
<u>sandy clay</u>	<u>0</u>	<u>42</u>
<u>shaly sandstone</u>	<u>42</u>	<u>47</u>
<u>dark grey limestone</u>	<u>47</u>	<u>135</u>
<u>hard grey limestone</u>	<u>135</u>	<u>255</u>
<u>green, soft limestone</u>	<u>255</u>	<u>257</u>
<u>hard, dense limestone</u>	<u>257</u>	<u>472</u>

WELL LOCATION: NE 3W NW
sec. 9 T. 2 N. R. 10 E
7 miles N of UKA
(distance) (direction) (nearest town)


WELL PURPOSE: UTILITY DISTRICT
(home, irrigation, municipal, industrial)

Small fracture
at 47 feet,
produces about
5 gpm.

WELL COMPLETION DATA:

- (1) diameter (inches) 6
- (2) total depth (feet) 472
- (3) static water level (feet) 14 (below)
top of ground. above
- (4) casing steel, 46,
(material) (depth)
6'14
(size) if telescope see back.
- (5) screen NONE
(length) (depth to top)
(size) (material)
- (6) pump NONE
(HP) (yield gpm)
(type power)
- (7) electric log yes
(yes or no)
USGS
(organization running log)
- (8) how well bottom plugged _____

DRILLED as test
well ONLY.

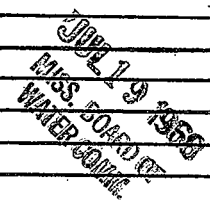


DRILLERS REMARKS: Expect to
drill deeper when
the money is
available.



If well telescopes please
sketch and show depths.

GROUND LEVEL

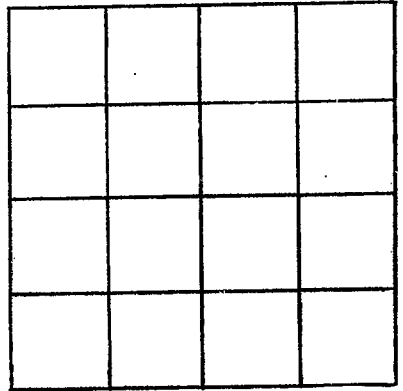

SECTION _____

Please indicate well location X.

ADDITIONAL INFORMATION

If more than one screen,
show locations of each on sketch.