

18R

CODED

Lishomingo
B8
12-3-68

MISSISSIPPI
BOARD OF WATER COMMISSIONERS
416 North State Street
Jackson, Mississippi 39201

WATER WELL DRILLERS LOG

Dec 3 1968 Hughes Well Drilling Lish. county well located
date well completed firm name

LANDOWNER:

James M. Mc. Duffy
Luka miss Raut 4
(mailing address)

description of formations encountered

from to

Clay 0 40
Sand shale stone 40 80
Slat Rock and soap stone 80 103

WELL LOCATION:

sec. 6 T 2 N R 10 E
2 miles N.W. of Cross Roads
(distance) (direction) (nearest town)

WELL PURPOSE: HOME
(home, irrigation, municipal, industrial)

WELL COMPLETION DATA:

- (1) diameter (inches) 6 1/2
- (2) total depth (feet) 103
- (3) static water level (feet) 40 below top of ground.
- (4) casing Galv. 93 (material) (depth)
- (size) if telescope see back.
- (5) screen (length) (depth to top) (size) (material)
- (6) pump 1/2 (HP) (yield gpm) 230 V. (type power)
- (7) electric log NO (yes or no) NO (organization running log) SLATE ROCK
- (8) how well bottom plugged

CODED

DRILLERS REMARKS:


Hughes well Drilling
Furnish Pump

DEC 17 1968

MISS. BD. OF WATER COMMISSIONERS

If well telescopes please sketch and show depths.

GROUND LEVEL

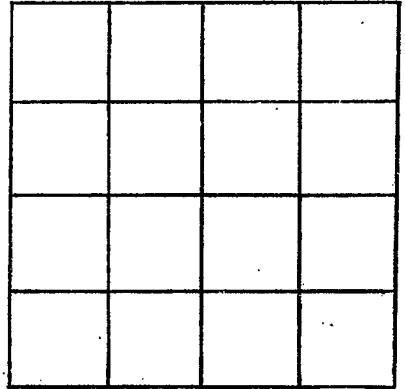

SECTION 6

Please indicate well location X.

ADDITIONAL INFORMATION

If more than one screen,
show locations of each on sketch.