

Tisho 2090  
 B9  
 1-15-69

MISSISSIPPI  
 BOARD OF WATER COMMISSIONERS CODED  
 416 North State Street  
 Jackson, Mississippi 39201 CODED

WATER WELL DRILLERS LOG

Jan-15-1969 Hester Well Drilling Lish  
 date well completed firm name county well located

LANDOWNER:	description of formations encountered	from	to
<del>William Proctor</del> William Proctor	Clay	0	30
Route #4 <u>data mis</u> (mailing address)	Shale	30	70
	Small Shell Rock	70	150
	Small Shell Rock		
	Small Shell Rock		

WELL LOCATION:  
 sec. 4 T. 2 N. R. 10E  
 (distance) (direction) (nearest town)  
 NORTH 2 MILES of CROSS ROADS  
 (distance) (direction) (nearest town)

WELL PURPOSE:  
 (home, irrigation, municipal, industrial)

WELL COMPLETION DATA:

(1) diameter (inches) 6"

(2) total depth (feet) 150

(3) static water level (feet) 60 below above top of ground.

(4) casing PLASTIC 140  
 (material) (depth)  
no if telescope see back.  
 (size)

(5) screen none  
 (length) (depth to top)  
none  
 (size) (material)

(6) pump 1 HP (yield gpm)  
230V  
 (type power)

(7) electric log no  
 (yes or no)  
no  
 (organization running log)

(8) how well bottom plugged Good

FEB 25 1969


DRILLERS REMARKS:  
Installed 1 HP Sumner  
pump and drilled tank  
owner will back to office

MISS. BO. OF  
 WATER COMMISSIONERS



If well telescopes please sketch and show depths.

GROUND LEVEL

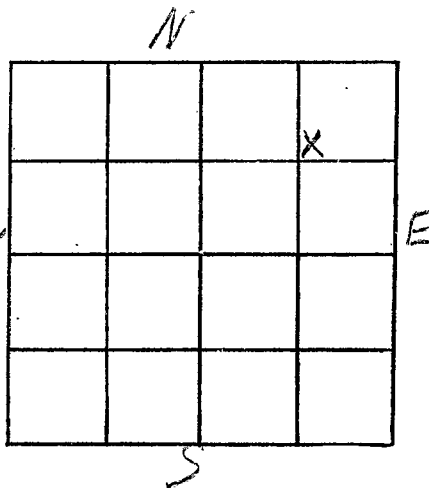

SECTION \_\_\_\_\_

Please indicate well location X.

ADDITIONAL INFORMATION

If more than one screen, show locations of each on sketch.