

CODED

MISSISSIPPI
BOARD OF WATER COMMISSIONERS
416 North State Street
Jackson, Mississippi 39201

WATER WELL DRILLERS LOG

Lishomings
B10
2-14-69

2-14-69 19 date well completed
Fairer Well Supply firm name
Lishomings county well located

LANDOWNER: C.C. Cummings
Burnsville Miss

description of formations encountered	from	to
	Red Clay & Sand	0

(mailing address)

WELL LOCATION:

sec 30 T 2 N R 40 E
S W
5 miles N of Burnsville
(distance) (direction) (nearest town)

CODED

WELL PURPOSE:

(home, irrigation, municipal, industrial)

WELL COMPLETION DATA:


- (1) diameter (inches) 4
- (2) total depth (feet) 75
- (3) static water level (feet) _____ below
top of ground. above
- (4) casing PVC 70
(material) (depth)
(size) if telescope see back.
- (5) screen 5
(length) (depth to top)
4" PVC
(size) (material)
- (6) pump None
(HP) (yield gpm)
(type power)
- (7) electric log _____
(yes or no)
(organization running log)
- (8) how well bottom plugged _____

DRILLERS REMARKS:

MISS. BD. OF
WATER COM.

If well telescopes please sketch and show depths.

GROUND LEVEL

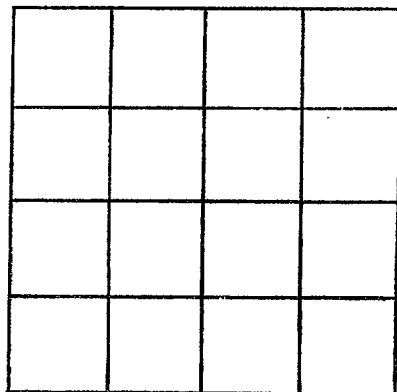

SECTION 30

Please indicate well location X.

ADDITIONAL INFORMATION

If more than one screen,
show locations of each on sketch.