

Leshomingo
B 14
5-30-69

MISSISSIPPI
 BOARD OF WATER COMMISSIONERS
 416 North State Street
 Jackson, Mississippi 39201

CODED

WATER WELL DRILLERS LOG

May 30 1969 Hughes Well Drillers Lish.
 date well completed firm name county well located

LANDOWNER: Rufus Gibson
5369 Shady Grove
Memphis Tenn.
 (mailing address)

description of formations encountered	from	to
<u>Dirt Gravel</u>	<u>0</u>	<u>20</u>
<u>Hard Chalk</u>	<u>20</u>	<u>110</u>
<u>Sand Rock</u>	<u>110</u>	<u>120</u>
<u>Blue Rock</u>	<u>120</u>	<u>188</u>

WELL LOCATION:
 sec. 14 T. 1 S. R. 10 E.
1 miles E of PL. Res.
 (distance) (direction) (nearest town)

WELL PURPOSE: Home
 (home, irrigation, municipal, industrial)

WELL COMPLETION DATA:

- (1) diameter (inches) 6 1/2
- (2) total depth (feet) 188
- (3) static water level (feet) 40 below above top of ground.
- (4) casing 4 1/2, 1 1/2,
 (material) (depth)
 _____ if telescope see back.
 (size)
- (5) screen no
 (length) (depth to top)

 (size) (material)
- (6) pump no
 (HP) (yield gpm)

 (type power)
- (7) electric log _____
 (yes or no)

 (organization running log)
- (8) how well bottom plugged _____


DRILLERS REMARKS:
Owner well install
owner pump

JUL 12 1969

MISS. BD. OF
 WATER COMM.

If well telescopes please
sketch and show depths.

GROUND LEVEL

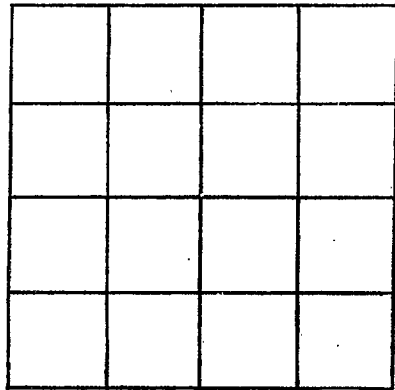

SECTION 14

Please indicate well location X.

ADDITIONAL INFORMATION

If more than one screen,
show locations of each on sketch.