

Leskovings
B10
6-4-69

MISSISSIPPI
 BOARD OF WATER COMMISSIONERS
 416 North State Street
 Jackson, Mississippi 39201

CODED

WATER WELL DRILLERS LOG

June 4 19 *69* *Hughes Well Drilling* *Tustin*
 date well completed firm name county well located


| LANDOWNER: <i>Bennil Douf</i> <i>Road</i> | description of formations encountered | from | to |
|---|--|----------|--------------------------------------|
| <i>Luka miss</i> (mailing address) | <i>Stratford</i> <i>Loop Stone</i> <i>Rock</i> | <i>0</i> | <i>20</i> <i>80</i> <i>160</i> |
| WELL LOCATION: sec. <i>14</i> T. <i>1</i> N. R. <i>10</i> E. S. <i>1</i> miles <i>E</i> of <i>P.L.R.</i> (distance) (direction) (nearest town) | | | |
| WELL PURPOSE: (home, irrigation, municipal, industrial) | | | |
| WELL COMPLETION DATA: | | | |
| (1) diameter (inches) <i>6 1/2</i> | | | |
| (2) total depth (feet) <i>188</i> | | | |
| (3) static water level (feet) <i>40</i> below top of ground. | | | |
| (4) casing <i>Galv</i> , <i>80</i> (material) (depth) | | | |
| _____ if telescope see back. (size) | | | |
| (5) screen _____ (length) (depth to top) | | | |
| _____ (size) _____ (material) | | | |
| (6) pump _____ (HP) _____ (yield gpm) | | | |
| _____ (type power) | | | |
| (7) electric log _____ (yes or no) | | | |
| _____ (organization running log) | | | |
| (8) how well bottom plugged _____ | | | |
| DRILLERS REMARKS: <i>no water well</i> <i>found in 1st 100</i> | | | |

JUN 12 1969

MISS. BD. OF
 WATER COMMISSIONERS

If well telescopes please sketch and show depths.

GROUND LEVEL

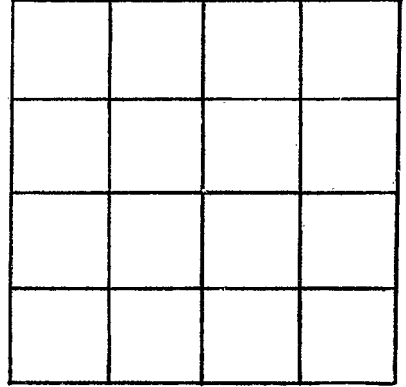

SECTION 14

Please indicate well location X.

ADDITIONAL INFORMATION

If more than one screen, show locations of each on sketch.