

Tishomingo  
B - 14  
7-14-71

MISSISSIPPI  
 BOARD OF WATER COMMISSIONERS  
 416 North State Street  
 Jackson, Mississippi 39201

**CODED**

WATER WELL DRILLERS LOG

7-14 1971 Bond Well Drilling Tishomingo  
 date well completed firm name county well located

LANDOWNER: <u>Fauman Bray</u>	description of formations encountered	from	to
<u>Burnville Miss</u> (mailing address)	<u>Red clay</u> <u>Yellow sand</u> <u>Water sand</u>	<u>0</u> <u>12</u> <u>30</u>	<u>12</u> <u>30</u> <u>63</u>
WELL LOCATION: sec. <u>30</u> T <u>2</u> N R <u>10</u> E <u>4</u> miles <u>N-E</u> of <u>Burnville</u> (distance) (direction) (nearest town)			
WELL PURPOSE: <u>Home</u> (home, irrigation, municipal, industrial)			
WELL COMPLETION DATA:			
(1) diameter (inches) <u>4</u>			
(2) total depth (feet) <u>63</u>			
(3) static water level (feet) <u>26</u> below above top of ground.			
(4) casing <u>Steel</u> , <u>63</u> (material) (depth)			
_____ (size) If telescope see back.			
(5) screen <u>perforated casing</u> (length) (depth to top)			
<u>4</u> _____ (size) (material)			
(6) pump _____ (HP) _____ (yield gpm) <u>Had on pump</u> (type power)			
(7) electric log <u>no</u> (yes or no)			
_____ (organization running log)			
(8) how well bottom plugged <u>yes</u>			
DRILLERS REMARKS:   			


**CODED**

AUG 11 1971

MISS. RD. OR  
 WATER BOARD

If well telescopes please sketch and show depths.

GROUND LEVEL

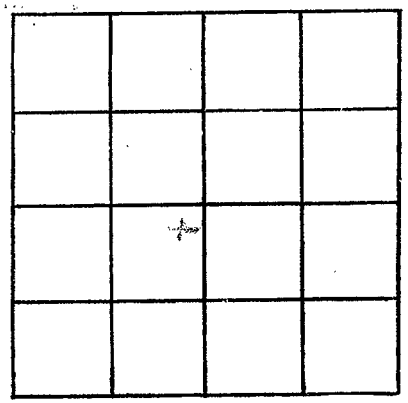

SECTION \_\_\_\_\_

Please indicate well location X.

ADDITIONAL INFORMATION

A series of horizontal lines for writing additional information, starting below the 'ADDITIONAL INFORMATION' header and extending to the bottom of the page.

If more than one screen, show locations of each on sketch.