

TISHOMINGO
 B 17
 5-15-73

MISSISSIPPI
 BOARD OF WATER COMMISSIONERS
 416 North State Street
 Jackson, Mississippi 39201

CODED

WATER WELL DRILLERS LOG

5-15 19 73 Bonds Well Drilling Co. Tishomingo
 date well completed firm name county well located

LANDOWNER: <u>Dugan Davis</u>	description of formations encountered	from	to
<u>Burnsville, Miss.</u> (mailing address)	<u>Road along water sand</u>	<u>0</u>	<u>36</u> <u>36</u> <u>73</u>
WELL LOCATION: sec. <u>19</u> T. <u>2</u> N. R. <u>10</u> E. (distance) miles <u>NE</u> (direction) of <u>Burnsville</u> (nearest town)			
WELL PURPOSE: <u>Home</u> (home, irrigation, municipal, industrial)			
WELL COMPLETION DATA: (1) diameter (inches) <u>4</u> (2) total depth (feet) <u>73</u> (3) static water level (feet) <u>32</u> <u>below</u> top of ground. (4) casing <u>Plastic</u> , <u>73'</u> (material) (depth) (size) if telescope see back. (5) screen <u>perforated casing</u> (length) (depth to top) (size) (material) (6) pump <u>hand on pump</u> (HP) (yield gpm) (type power) (7) electric log <u>NO</u> (yes or no) (organization running log) (8) how well bottom plugged <u>plugged</u>			
DRILLERS REMARKS:			


CODED

JUN 8 1973

MISSISSIPPI
 COMM.

If well telescopes please sketch and show depths.

GROUND LEVEL

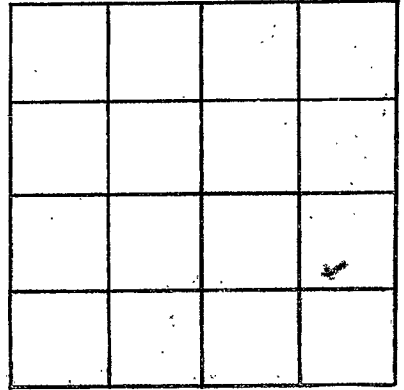

SECTION _____

Please indicate well location X.

ADDITIONAL INFORMATION

If more than one screen, show locations of each on sketch.