

TISHOMINGO
B18
5-17-73

MISSISSIPPI
BOARD OF WATER COMMISSIONERS
416 North State Street
Jackson, Mississippi 39201

CODED

WATER WELL DRILLERS LOG

5-17 1973 Bandera Well Drilling Tishomingo
date well completed: firm name county well located

LANDOWNER: Kay Lambert

description of formations encountered from to

Burnsville, Miss
(mailing address)

Red clay	0	40
Blue clay	40	62
Water sand	62	106

WELL LOCATION:
sec. 19 T 2 N R 10E
4 miles NE of Burnsville
(distance) (direction) (nearest town)

WELL PURPOSE: Home
(home, irrigation, municipal, industrial)

WELL COMPLETION DATA:

- (1) diameter (inches) 4
- (2) total depth (feet) 106
- (3) static water level (feet) 55 ^{below} above top of ground.
- (4) casing plastic 106
(material) (depth)
 if telescope see back.
(size)
- (5) screen galvanized
(length) (depth to top)
 (size) (material)
- (6) pump Hendon
(HP) (yield gpm)
 (type power)
- (7) electric log no
(yes or no)
 (organization running log)
- (8) how well bottom plugged Always


CODED

DRILLERS REMARKS:

JUN 6 1973

If well telescopes please sketch and show depths.

GROUND LEVEL

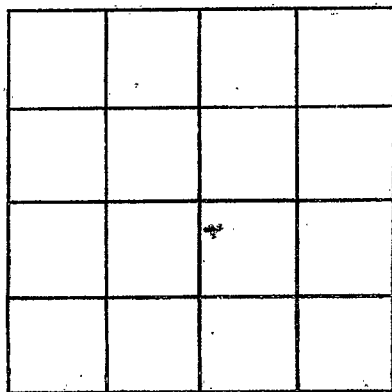

SECTION _____

Please indicate well location X.

ADDITIONAL INFORMATION

If more than one screen,
show locations of each on sketch.