

TISH.
B 24
10-5-73

MISSISSIPPI
BOARD OF WATER COMMISSIONERS
416 North State Street
Jackson, Mississippi 39201

OCT 19 1973

CODED

WATER WELL DRILLERS LOG


10-5 1973 Bonds Well Drilling Lishomingo
date well completed firm name county well located

LANDOWNER:	description of formations encountered	from	to
Irma Hubbard Burnsville, Miss. (mailing address)	Red Clay Blue Clay Water Sand	0 20 40	20 40 120
WELL LOCATION:			
sec. 29 T 2 N R 10 E 5 miles NE of Burnsville (distance) (direction) (nearest town)			
WELL PURPOSE: Home (home, irrigation, municipal, industrial)			
WELL COMPLETION DATA:			
(1) diameter (inches) 4			
(2) total depth (feet) 120			
(3) static water level (feet) 35 below top of ground.			
(4) casing Plastic 120 (material) (depth)			
_____ If telescope see back. (size)			
(5) screen Perforated (length) (depth to top)			
4 (size) (material)			
(6) pump Hodon (HP) (yield gpm)			
(type power)			
(7) electric log NO (yes or no)			
(organization running log)			
(8) how well bottom plugged plugged			
DRILLERS REMARKS:			

CODED

If well telescopes please sketch and show depths.

GROUND LEVEL

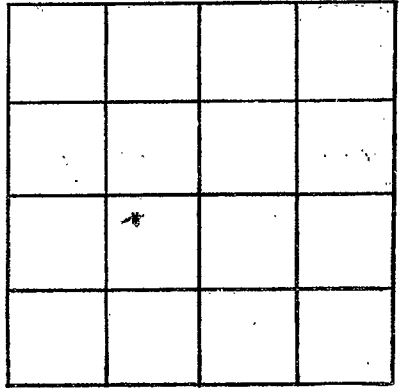

SECTION _____

Please indicate well location X.

ADDITIONAL INFORMATION

If more than one screen, show locations of each on sketch.