

TISH.
 B29
 10-1-74

MISSISSIPPI
 BOARD OF WATER COMMISSIONERS
 416 North State Street
 Jackson, Mississippi 39201

CODED

WATER WELL DRILLERS LOG

10-1 date well completed 1974 Bonds Well Drilling firm name Tishamingo county well located

LANDOWNER: Evelyn Embrey
 Burnsville
 Mississippi
 (mailing address)

description of formations encountered	from	to
	Red clay	0
yellow sand	15	30
white sand	30	56

WELL LOCATION:
 sec 31 T 2 N R 10 E 18R
 3 miles NNE of Burnsville
 (distance) (direction) (nearest town)

WELL PURPOSE: Home
 (home, irrigation, municipal, industrial)

- WELL COMPLETION DATA:
- (1) diameter (inches) 4"
 - (2) total depth (feet) 56
 - (3) static water level (feet) 24 ~~below~~ above top of ground.
 - (4) casing Plastic 56,
 (material) (depth)
 (size) if telescope see back.
 - (5) screen Perforated
 (length) (depth to top)
 (size) (material)
 - (6) pump 3/4 10
 (HP) (yield gpm)
 Sub
 (type power)
 - (7) electric log NO
 (yes or no)
 (organization running log)
 - (8) how well bottom plugged plugged

CODED




MAR 13 1975

DRILLERS REMARKS:

If well telescopes please sketch and show depths.

GROUND LEVEL

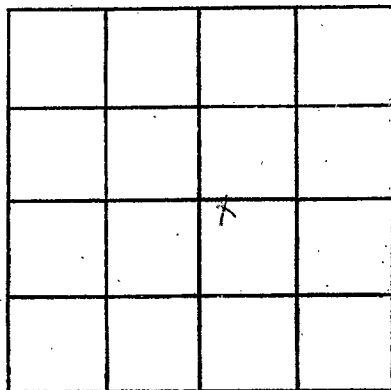

SECTION _____

Please indicate well location X.

ADDITIONAL INFORMATION

If more than one screen, show locations of each on sketch.