

18R

TISHOMINGO
C 2
10-1-68

MISSISSIPPI
BOARD OF WATER COMMISSIONERS
416 North State Street
Jackson, Mississippi 39201

CODED

WATER WELL DRILLERS LOG

0201 1968 Hughes Well Drilling Tishomingo
date well completed firm name county well located

LANDOWNER: Clayton Keenan
Rau # 3
Luka miss
(mailing address)

description of formations encountered	from	to
Clay	0	20
Chert	20	40
Shale	40	90
Sand	90	93

WELL LOCATION:
sec 33 T 2 N R 11 E
5 1/2 miles NORTH of Luka
(distance) (direction) (nearest town)

WELL PURPOSE: Home
(home, irrigation, municipal, industrial)

WELL COMPLETION DATA:

- (1) diameter (inches) 5.58
- (2) total depth (feet) 93.20
- (3) static water level (feet) 50 below top of ground
- (4) casing Galv. 310 (material) (depth)
(size) if telescope see back.
- (5) screen NONE (length) (depth to top)
(size) (material)
- (6) pump 1/2 (HP) 10 (yield gpm)
Elec (type power)
- (7) electric log NO (yes or no)
(organization running log)
- (8) how well bottom plugged

CODED


APR 17 1968

DRILLERS REMARKS:

MISS. Bd. OF WATER COMM.

If well telescopes please sketch and show depths.

GROUND LEVEL

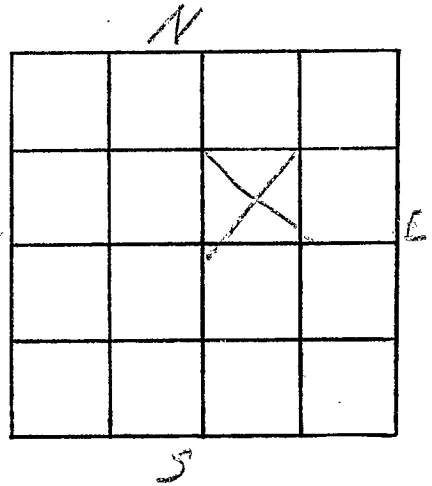

SECTION _____

Please indicate well location X.

ADDITIONAL INFORMATION

If more than one screen,
show locations of each on sketch.