

18R

TISH  
C 3  
10-21-68

MISSISSIPPI  
BOARD OF WATER COMMISSIONERS  
416 North State Street  
Jackson, Mississippi 39201

**CODED**

WATER WELL DRILLERS LOG

10-21-68 19 Hugner Well Drilling Lish.  
date well completed firm name county well located

LANDOWNER: Lula Hugner  
Route # 3  
Lula miss  
(mailing address)

description of formations encountered	from	to
<u>Clay</u>	<u>0</u>	<u>90</u>
<u>Chalk</u>	<u>90</u>	<u>120</u>
<u>Clay and gravel</u>	<u>120</u>	<u>160</u>
<u>Rock</u>	<u>160</u>	<u>200</u>

WELL LOCATION:  
sec. 33 T. 2 N. R. 11 E.  
5 miles NORTH of Lula  
(distance) (direction) (nearest town)

WELL PURPOSE: Home  
(home, irrigation, municipal, industrial)

WELL COMPLETION DATA:

- (1) diameter (inches) 5 5/8
- (2) total depth (feet) 200
- (3) static water level (feet) 130 below above top of ground.
- (4) casing Block, 140  
(material) (depth)  
         if telescope see back.  
(size)
- (5) screen None  
(length) (depth to top)  
         (size) (material)
- (6) pump 1/2 10  
(HP) (yield gpm)  
Elec  
(type power)
- (7) electric log NO  
(yes or no)  
         (organization running log)
- (8) how well bottom plugged

**CODED**

OCT 17 1968

MISS. Bd. OF  
WATER COMMISSIONERS


DRILLERS REMARKS:

If well telescopes please sketch and show depths.

GROUND LEVEL

*NNW*

*NE*

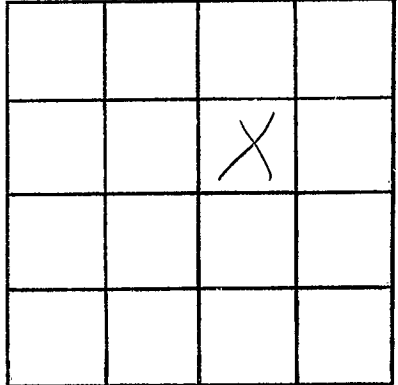

*SW*

*SE*

SECTION 74

Please indicate well location X.

ADDITIONAL INFORMATION

If more than one screen, show locations of each on sketch.