

18R

Lishomps  
C 4  
11-7-68

MISSISSIPPI  
BOARD OF WATER COMMISSIONERS  
416 North State Street  
Jackson, Mississippi 39201

CODED

WATER WELL DRILLERS LOG

CODED

11-7-1968 date well completed  
Hughes Well Drilling firm name  
Lish county well located

LANDOWNER: J.R. Riggins  
253 S. McLean  
Memphis Tenn.  
(mailing address)

description of formations encountered	from	to
Dirt Shell	0	27
Black Rock	27	209

WELL LOCATION:  
sec. 23 T. 22 N R. 11 E  
7 miles NE of Luka  
(distance) (direction) (nearest town)

WELL PURPOSE: Home  
(home, irrigation, municipal, industrial)

WELL COMPLETION DATA:

- (1) diameter (inches) 5.56
- (2) total depth (feet) 209
- (3) static water level (feet) 18 below top of ground.
- (4) casing Galv. (material), 27 ft (depth)  
if telescope see back.
- (5) screen NONE (length), (depth to top)  
(size) (material)
- (6) pump (HP) (yield gpm)  
(type power)
- (7) electric log 0 (yes or no)  
(organization running log)
- (8) how well bottom plugged SOLID ROCK


CODED

MISS. Bd. of  
WATER COMMISSIONERS  
JAN 5 1968

DRILLERS REMARKS: Well supply  
own pump.

If well telescopes please sketch and show depths.

GROUND LEVEL

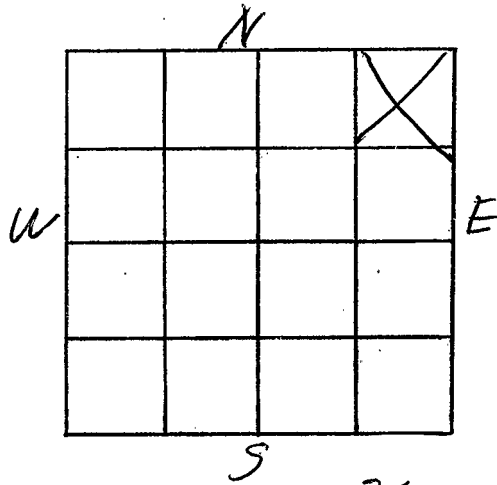

SECTION 23

Please indicate well location X.

ADDITIONAL INFORMATION

If more than one screen, show locations of each on sketch.