

18R.

Lishomungo
C5
11-9-68

MISSISSIPPI
BOARD OF WATER COMMISSIONERS
416 North State Street
Jackson, Mississippi 39201

CODED

WATER WELL DRILLERS LOG

11-9 1968 Hughes Well Drilling Lish
date well completed firm name county well located


LANDOWNER: Shannon Wood 1736 Clair ave Memphis Tenn. (mailing address)	description of formations encountered	from	to
	Dirt Gravel	0	78
	Block Rock	78	103
WELL LOCATION:			
sec. 7 T. 11 N. R. 11 E			
7 miles NE of Delta			
WELL PURPOSE: Home (home, irrigation, municipal, industrial)			
WELL COMPLETION DATA:			
(1) diameter (inches) 5 1/8			
(2) total depth (feet) 103			
(3) static water level (feet) 75 below top of ground.			
(4) casing Galv. 78 (material) (depth)			
(size) if telescope see back.			
(5) screen NONE (length) (depth to top)			
(size) (material)			
(6) pump (HP) (yield gpm)			
(type power)			
(7) electric log (yes or no)			
(organization running log)			
(8) how well bottom plugged			
DRILLERS REMARKS: Well supply over pump			

CODED

NOV 25 1968
MISS. BD. OF
WATER COMMISSIONERS

If well telescopes please sketch and show depths.

GROUND LEVEL

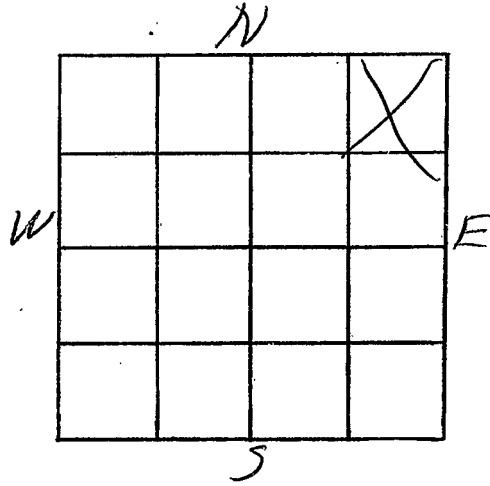

SECTION 23

Please indicate well location X.

ADDITIONAL INFORMATION

If more than one screen, show locations of each on sketch.