

Lishomings
C 6
5-22-69

MISSISSIPPI
BOARD OF WATER COMMISSIONERS
416 North State Street
Jackson, Mississippi 39201

CODED

WATER WELL DRILLERS LOG

may 22 19 *Huger well Drilling List*
date well completed firm name county well located

LANDOWNER: *T. Cropper*
3554 Bowen
Memphis Tenn.
(mailing address)

description of formations encountered	from	to
Shallow <i>Shallow Sand</i>	0	23
<i>Black Rock</i>	23	26

WELL LOCATION:
sec. 28 T. 2 N. R. 11 E
7 miles N of Duck
(distance) (direction) (nearest town)

WELL PURPOSE: *Open*
(home, irrigation, municipal, industrial)

- WELL COMPLETION DATA:
- (1) diameter (inches) 6 1/4
 - (2) total depth (feet) 75
 - (3) static water level (feet) 20 below top of ground.
 - (4) casing Plexic 23
(material) (depth)
 if telescope see back.
(size)
 - (5) screen (length) (depth to top)
 (size) (material)
 - (6) pump (HP) (yield gpm)
 (type power)
 - (7) electric log (yes or no)
 (organization running log)
 - (8) how well bottom plugged


JUN 12 1969

DRILLERS REMARKS:
*0 run? stop at 25 ft
for water no water*

MISS. BD. OF
WATER COMM.

If well telescopes please
sketch and show depths.

GROUND LEVEL

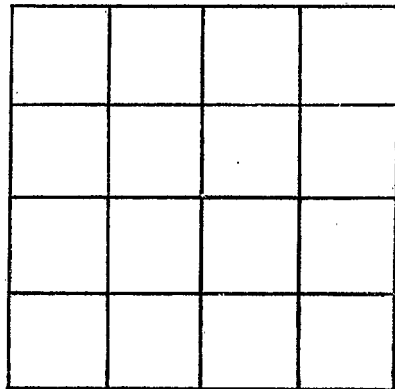

SECTION 28

Please indicate well location X.

ADDITIONAL INFORMATION

If more than one screen,
show locations of each on sketch.